
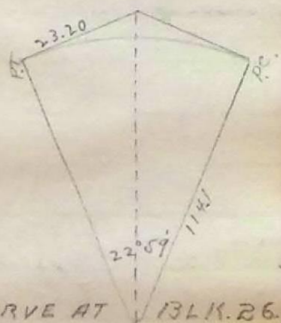


Sketch of last eleven blocks showing size of irregular lots, curves & location of monuments.

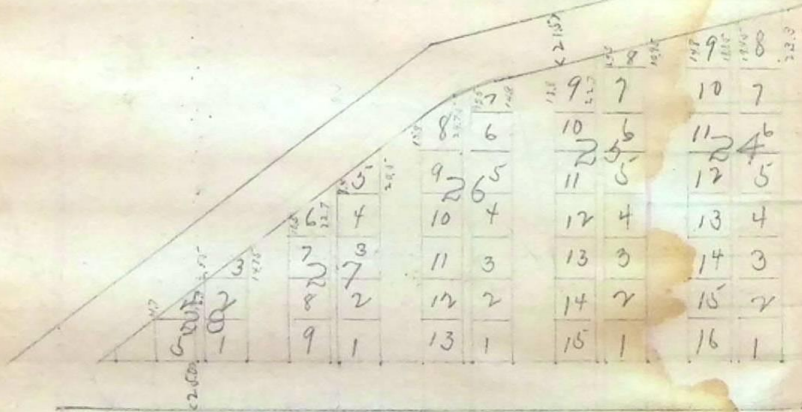

CURVE AT BLK. 26. 44.2 C.L.

Set monument on south line 2.45 ft west of South west corner of Block 17  
 Set monument on north line 2.45 ft west of North west corner of Block 17. This monument is also the angle point of line produced south west.

51°30' angle of curve

Short tangent of curve at Block 19 is 12.53 ft

Long tangent of curve at Block 26 is 23.20 ft



CURVE AT BLK. 19.

142° angle of curve

23.6 L.C.

														22	2
														23	1

MONUMENT