


Center sec. 30 Ties to TUNRIW

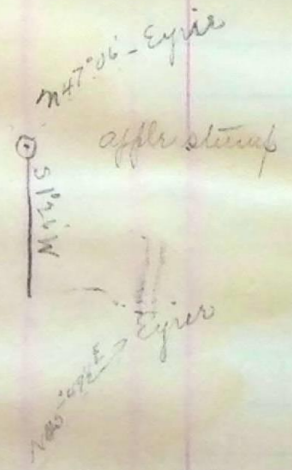

① Ogden City Corporation post
near 4th Central track