Description of a County Road
4 Rods wide leading from Monument 3
described above, westward through Manistee ville
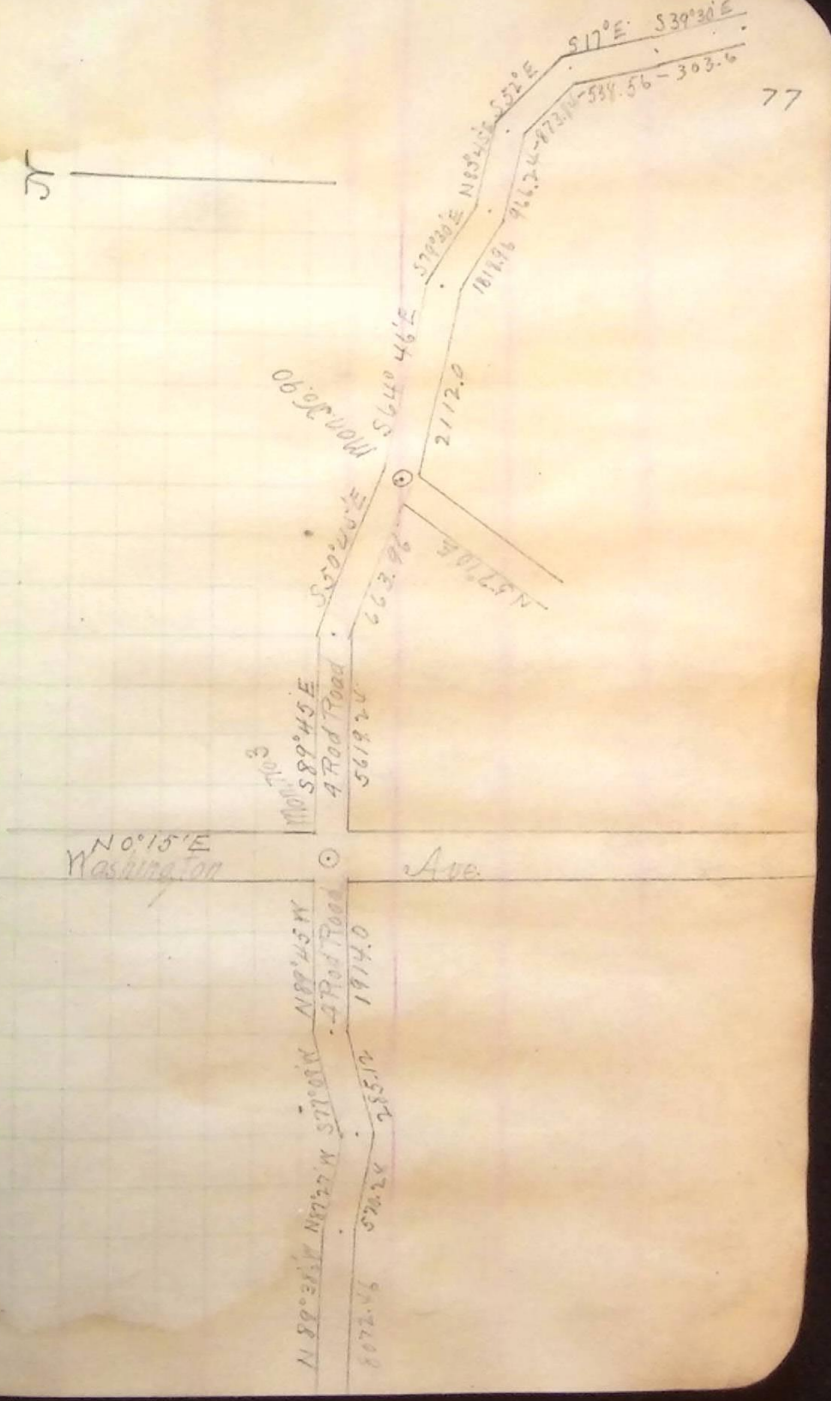
Beginning at the center of Main
Street at what is known and designated as
Monument No 3 near the Mound Fort School
House and running thence N89°45'W 29 ch.
(1914 ft.) in the center of said road, thence
S 77°09'W 4.32 ch. (285.12 ft.) thence N87°27'W.
8.64 ch. (570.24 ft.) thence N89°38½'W 122.31 ch.
8072.46 ft. to monument No 78 situated in the
center of the street near the Manistee ville
School House.