

422-12

7630 acres

67448

1500

66097

3009

63109

~~60977~~

78.14

640 ch

71.29

~~70.96~~

38

19.30 E

11.00

5.44

9.12

2.57


9.14

9.14

5  
4  
0.68 ch along center Road

26

John Chugg

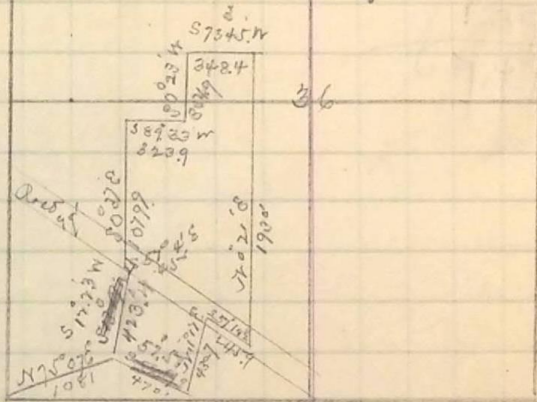

= sta 10 + 81

take this angle out make it straight from 63+08.7 to 67+08.7

Set v. sep next page.