

65

64

63

62


61

60

337

22

23

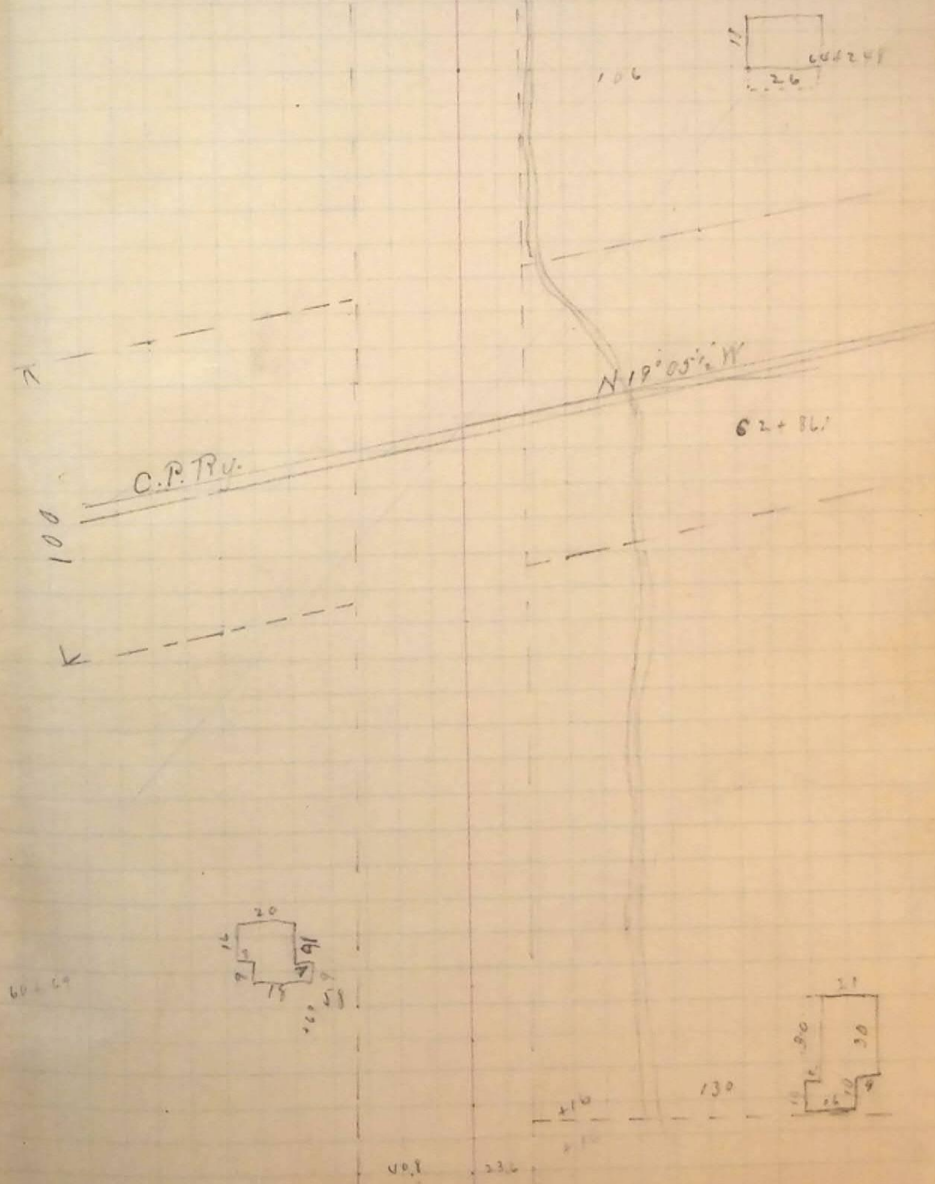

C.P. Rd.

N 12° 05' W



62+86

100

100

26

60+24

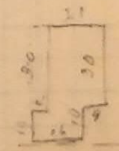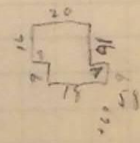

40.1

33.6

110

130

20

20

24

2

2

21