

Survey for O.J. Stillwell

Charges \$4.00

Monday July 11-11

Lot 2 Block 17 Plot A.

12
17
1604
1204

212
213

132.68
17
132.85

292
212
84

Line of Measurements on Washington Ave.


762.4

663.4 Block 17 San Wash

Northside of Brick No

North side Building No 2570
and 2592 on 17th north
and of Lot 2 Block 17 P.A.

Lot 2 Block 17 Plot A 132.68' North
and South

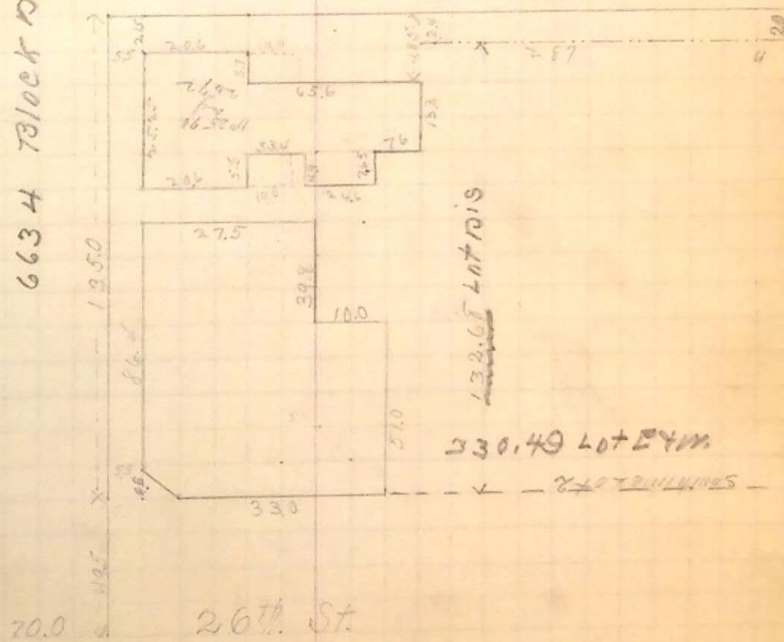

26th St

132.68 Lot 2 P.A.