

Surrey for Mrs. Greenwell

March 30<sup>th</sup> 1897


28

A part of Lot 6. Block 3 Plat B. O. C. S.

Commencing at a point 7 rods East  
of the North West Corner of said lot  
3 thence South 8 rods thence East 80 ft.  
thence North 8 rods thence West 80 ft to place  
of Beginning.

N.B. Set two stakes 49.5 west of east line.

Monroe Ave

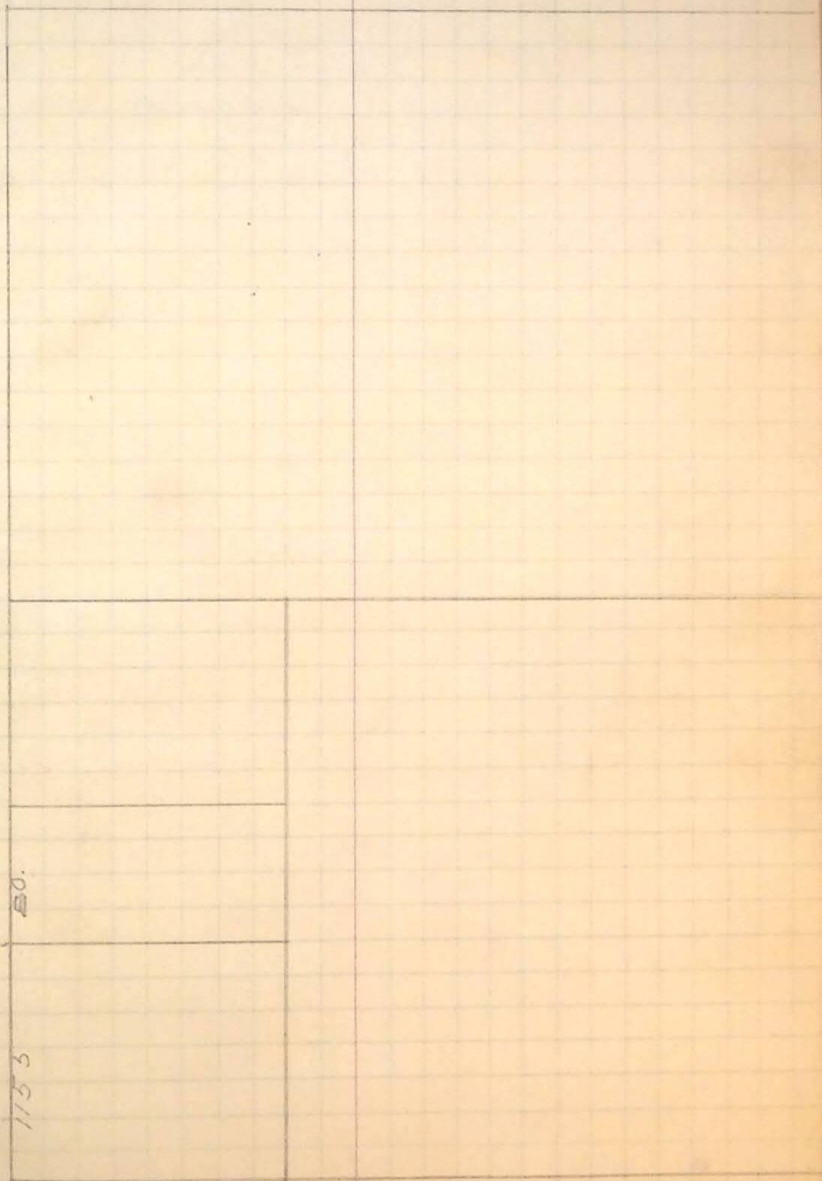

26.5

80

80

113.3

Madison Ave