


Slinger 8" x 10" x 1' 4' Center to C
 Hole 12" x 16"
 Boards 12" x 30" x 2"
 4" from Top of Plank to Bottom of Hole


Prop Line

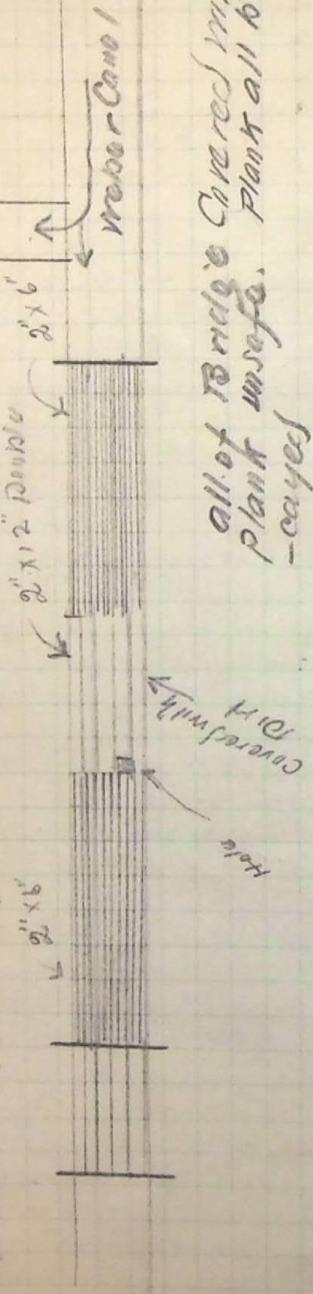

all of Bridge Covered with
 plank unsafe. Plank all being de
 -cayed

May 24 1898

25th 54

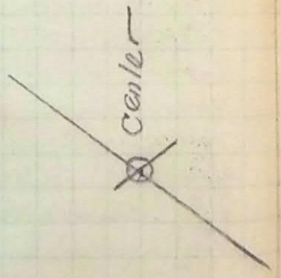

Adams ← North