


June 15th 1898

Survey for W.T. Pickett

Description

A part of Lot 1 & 10 in Block  
 43 Plat 20 O.C.S. 173 Commencing  
 108 3/4 ft. West of the South East  
 Corner of Sawy for 1. and running  
 thence West 40 ft. thence North  
 10 rods 165 ft. thence East 40 ft.  
 thence South 10 rods 165 ft. to place  
 of Beginning

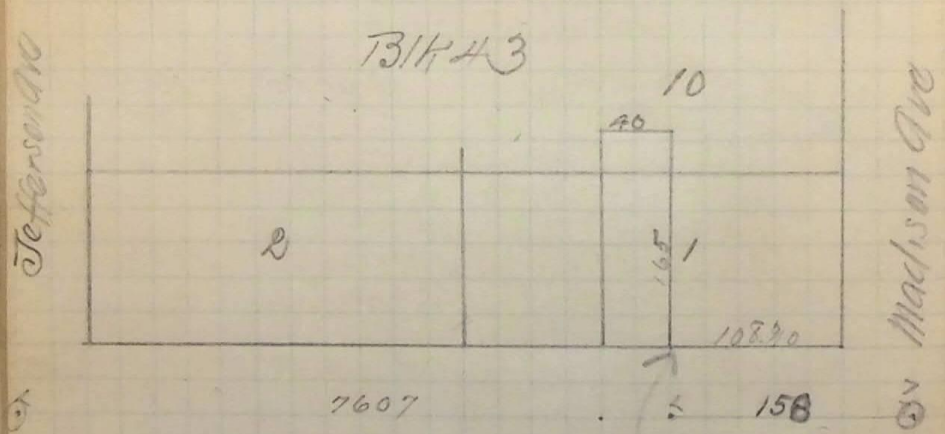

Set stake 33' E of  
 22nd St