November 2nd 1898

Survy for A. L. White - Lumber helper.

Description from White's Deed

A part of Lot 4

Blk 31 Plat A. Biging at a point 68 ft. N.
of S. W. Cor. said lot 4 thence N. 40 ft. thence
East 132 ft. th. S. 40 ft. th W. 132 ft. to biginig

My Measure between monuments with 16 lb. pull
= 762.63 or .27 over recorded dist.
= .000 357 correction
382.844 corrected = 382.98 dist used from Mont. 24th St. North
40.0 " = 40.015 " " " 382.98 N.

South line of lot hits 10" South of
north line of Party wall
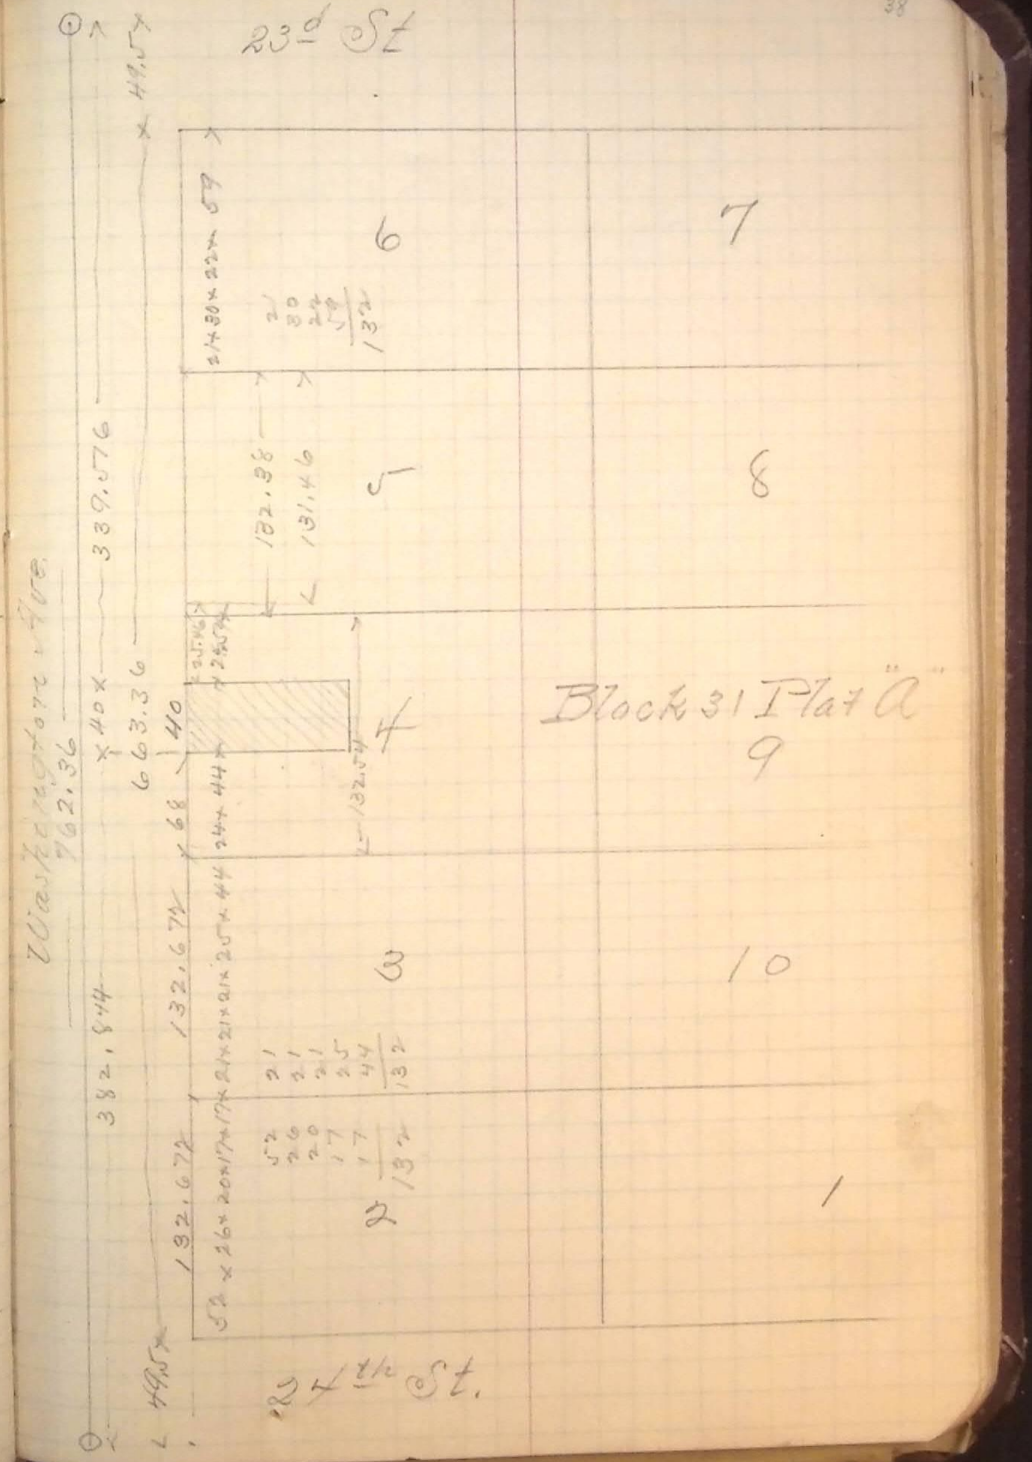
Paid Sumner $1.00