

Survey for Jas Mc Beth, Jan. 10th

A part of Lot 1 Blk 11 Plat B. C.C.S.
 Beg. 82.5 ft E. and 16.6 ft. of S.W. cor Lot 1.
 Thence 58.7 ft N. Thence 1.03 ft E. &c to close

Beg. 82.5 ft E. and 16.6 ft N. of S.W. cor Lot 1
 Thence N. 92 ft. E. 7.03 ft. S. 92 ft W. 7.03 ft

Deed -

Beg. 14 rods 15 1/2 ft. [84.75 ft] W. of S. E. cor, sd Lot 1
 Thence N. 92 ft. - W. 6.5 ft. - N. 40 ft. - W. 5 ft. [82.5 ft]
 S 2.5 ft [41.25] - E. 2.5 ft. [41.25] - S. 5.5 ft [92.75]
 E 42 ft 5" = [42.25] to Beginning

Mortgage

Beg 2.5 rods [41.25] ft E. of S.W. cor, sd, Lot 1
 Thence N. 8 rods [137.00] ft. - E. 2.5 rods [41.25] ft - S 8 rods
 [132] ft. - W. 2.5 rods [41.25] ft to beginning

Deed

Beg. 77 1/2 ft. E. of S.W. cor, sd, Lot 1.
 Thence N. 5.5 rods [92.25] ft. - W 6 ft. - N 2 1/2 rods [41.25] ft
 - E. 3 1/2 rods = [57.25] S. 8 rods. [132.] ft. - W. 51.75 ft to Beg

White measure 77.52 corr. = .00058

385.535 = 385.766

Measure from Net 84 - N lot cor 49.3 S Lot cor 50.1

" " " 83 " " " 53.1 " " 51.0

41.25 = 41.28 47.28

47.25 = 47.28 41.28

41.78 = 41.81 51.75

52 ft from fence post to 57.99


41.31

52 ft from fence post to 57.99

41.31

Abandoned and finished or done over on
 Jan 12th 1899


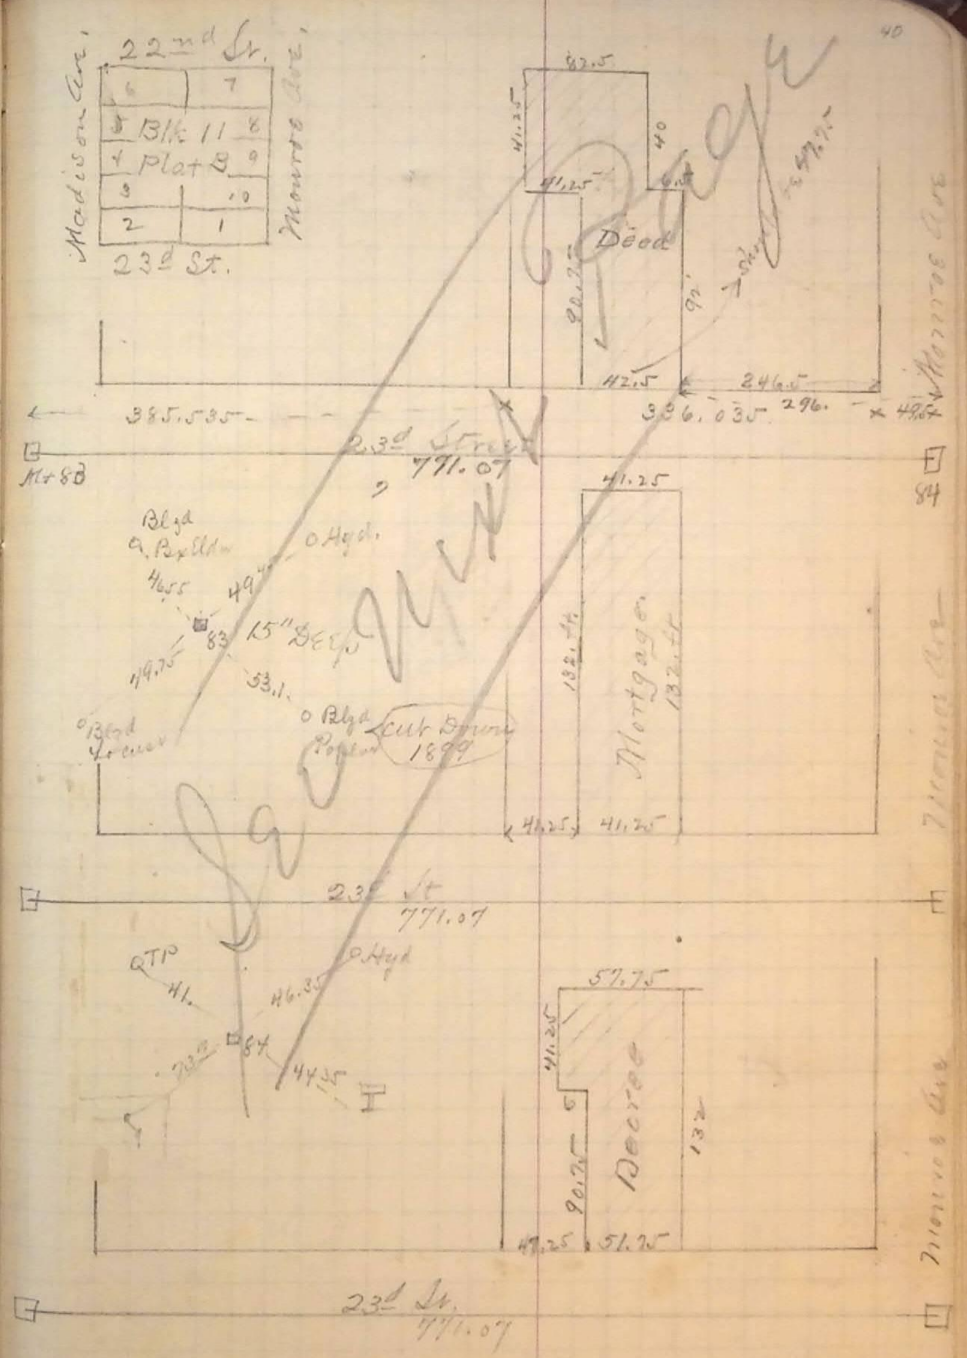

Monroe Ave