

March 6th 1899

Survey in Sec 30. T. 6 N. R. 1. W. for
Tanner law suit.

Summer } chain
Stoddard }

Found E. 1/4 cor of Sec. 30 = fence post.
offset 14.5 N. in gateway. Lines start
random by middle crossing W. through
ctr. of Sec. 30.

Measure W. on Random 129.5 to fence
Fence to water 20'


Set pt. on line at ① 115 ft.
Sub. at ① B.S. at gate angle L. $90^{\circ}20'$
Set sub ② for triangulation 150' North.
Set sub ③ and ④ on Random line W.
Just at ② B.S. on ① ang to ③ $31^{\circ}56'$
" " ④ $58^{\circ}29'$

Then Sub. at ④ distance W. 480 set ⑤

Set ahead W. on Random ⑥ ⑨

Dist from ① to ④ = Tan. $58^{\circ}29' \times 150 = 244.62$
" " ① " ③ " $31^{\circ}56' \times 150 = 93.10$
151.52

Abandoned
A. F. P.

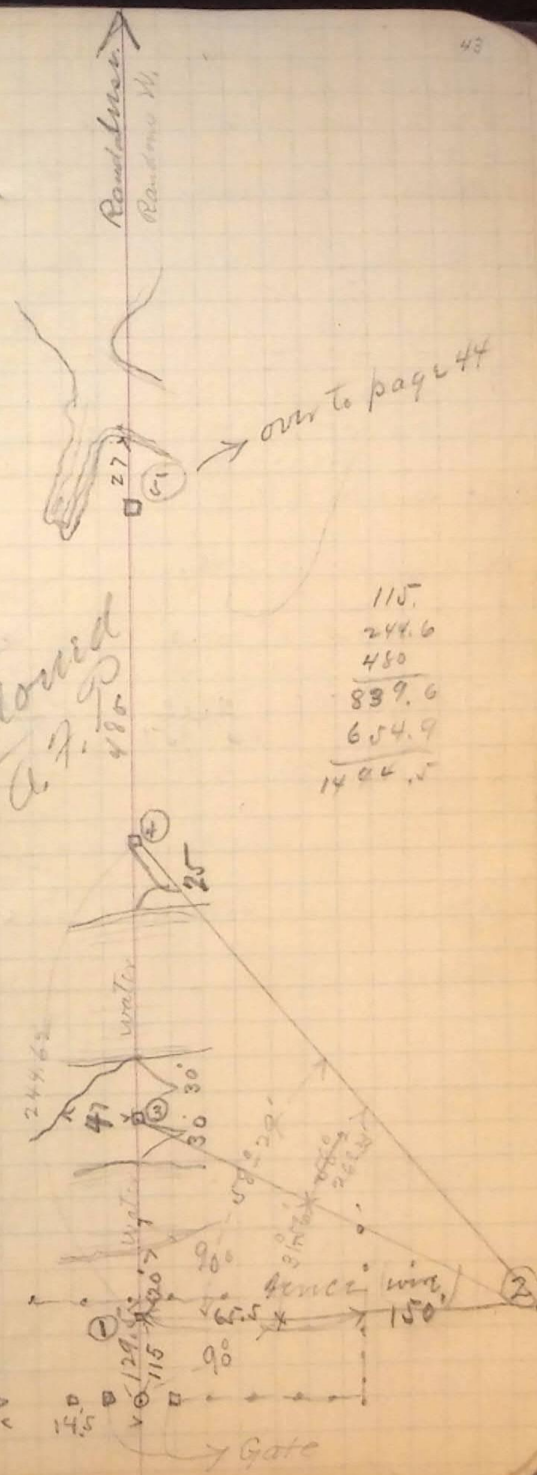

115.
244.6
480
839.6
654.9
1494.5

~~58-29~~
~~31-56~~