


May 31<sup>st</sup> 1899 Scotland J. Helms  
Lines of 27<sup>th</sup> St. for Paris Dist No 3

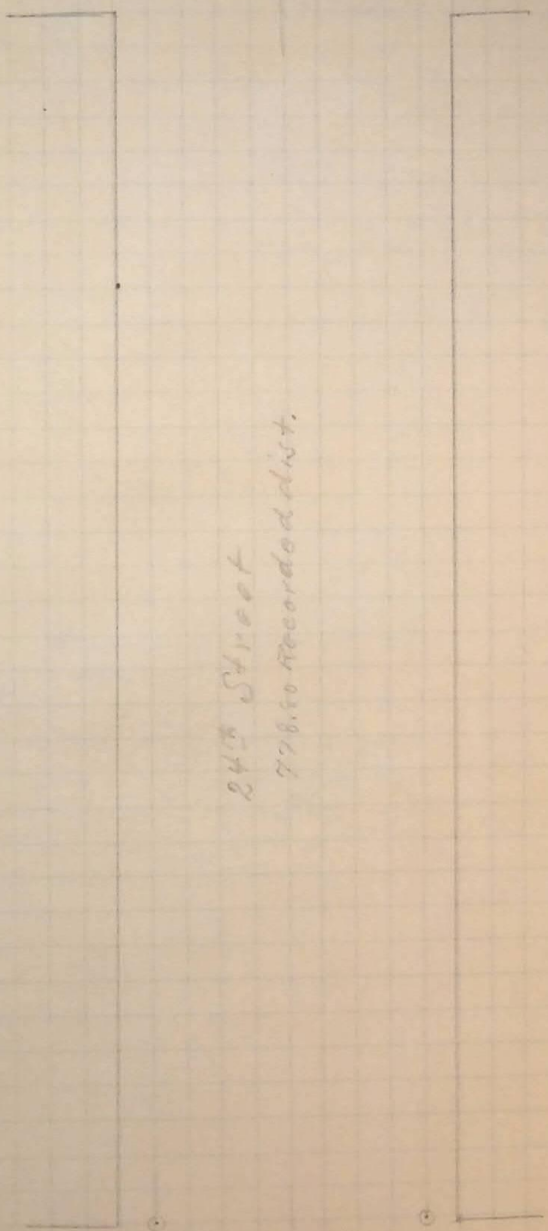

Was in Ave