


Feb 23^d 1900

Meas. for House No. Adams Ave

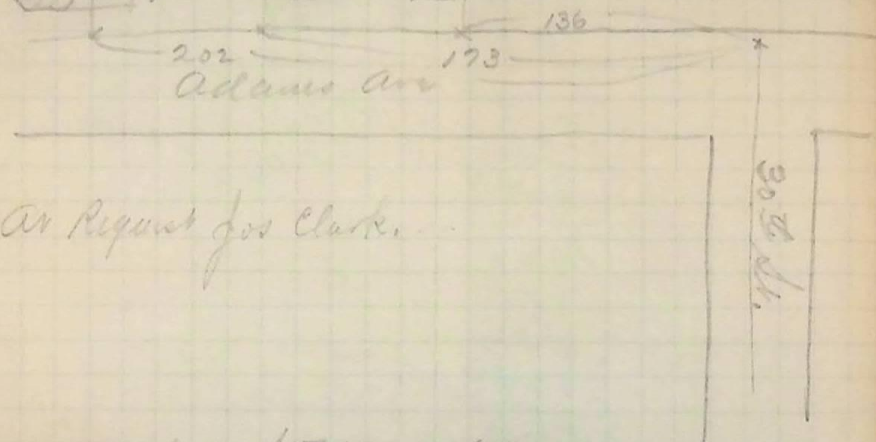

As Request for Clark.

$$\text{Clr } 29^{\text{th}} \text{ St} = \text{Sta } 77 + 12.85$$

$$\text{Clr } 30^{\text{th}} \text{ St} = \text{Sta } 69 + 53.85$$

$$759 \text{ ft.}$$

$$89.5$$

$$670.5 = \text{Block meas}$$

$$670.5 - (202 - 40) = 508.5 \text{ from } 29^{\text{th}} \text{ St.}$$

$$670.5 - (173 - 40) = 537.5 \text{ " " "}$$

$$670.5 - (136 - 40) = 574.5 \text{ " " "}$$

Clr 30th St