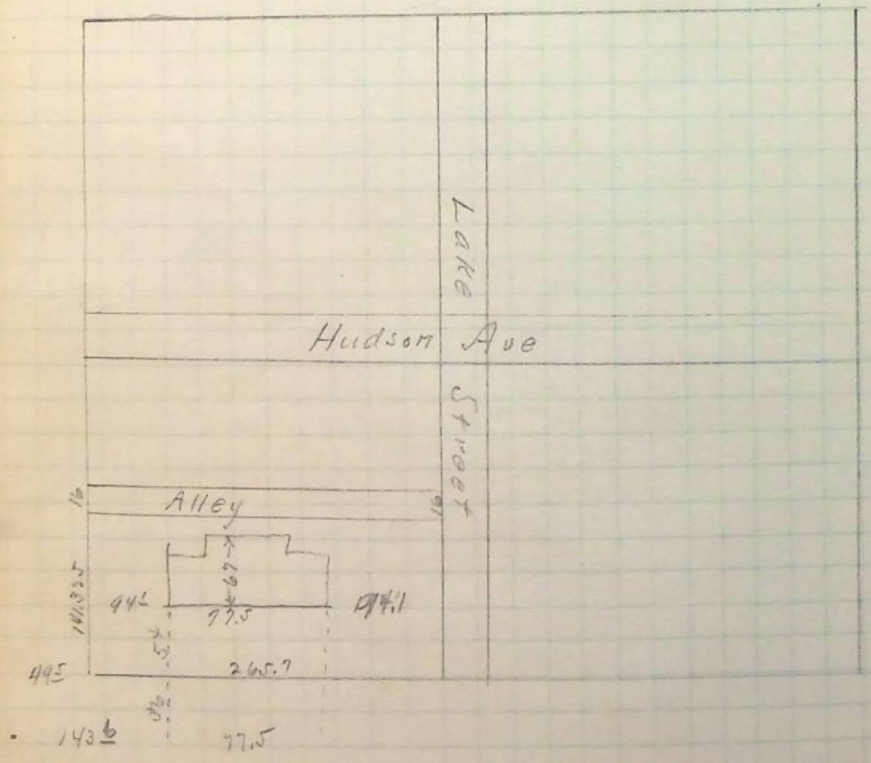

265.7 — 45 — 6 — 141.325 — 8.75 — 66
77.5 — 19 — 9 — 87
2 | 188.2 — 1.9 — 54.325 — 4.72
94.1 — 67 — 56 — .5
49.5 — 110.825 — 3.22
148.6
4.72
4.75