April 15-03
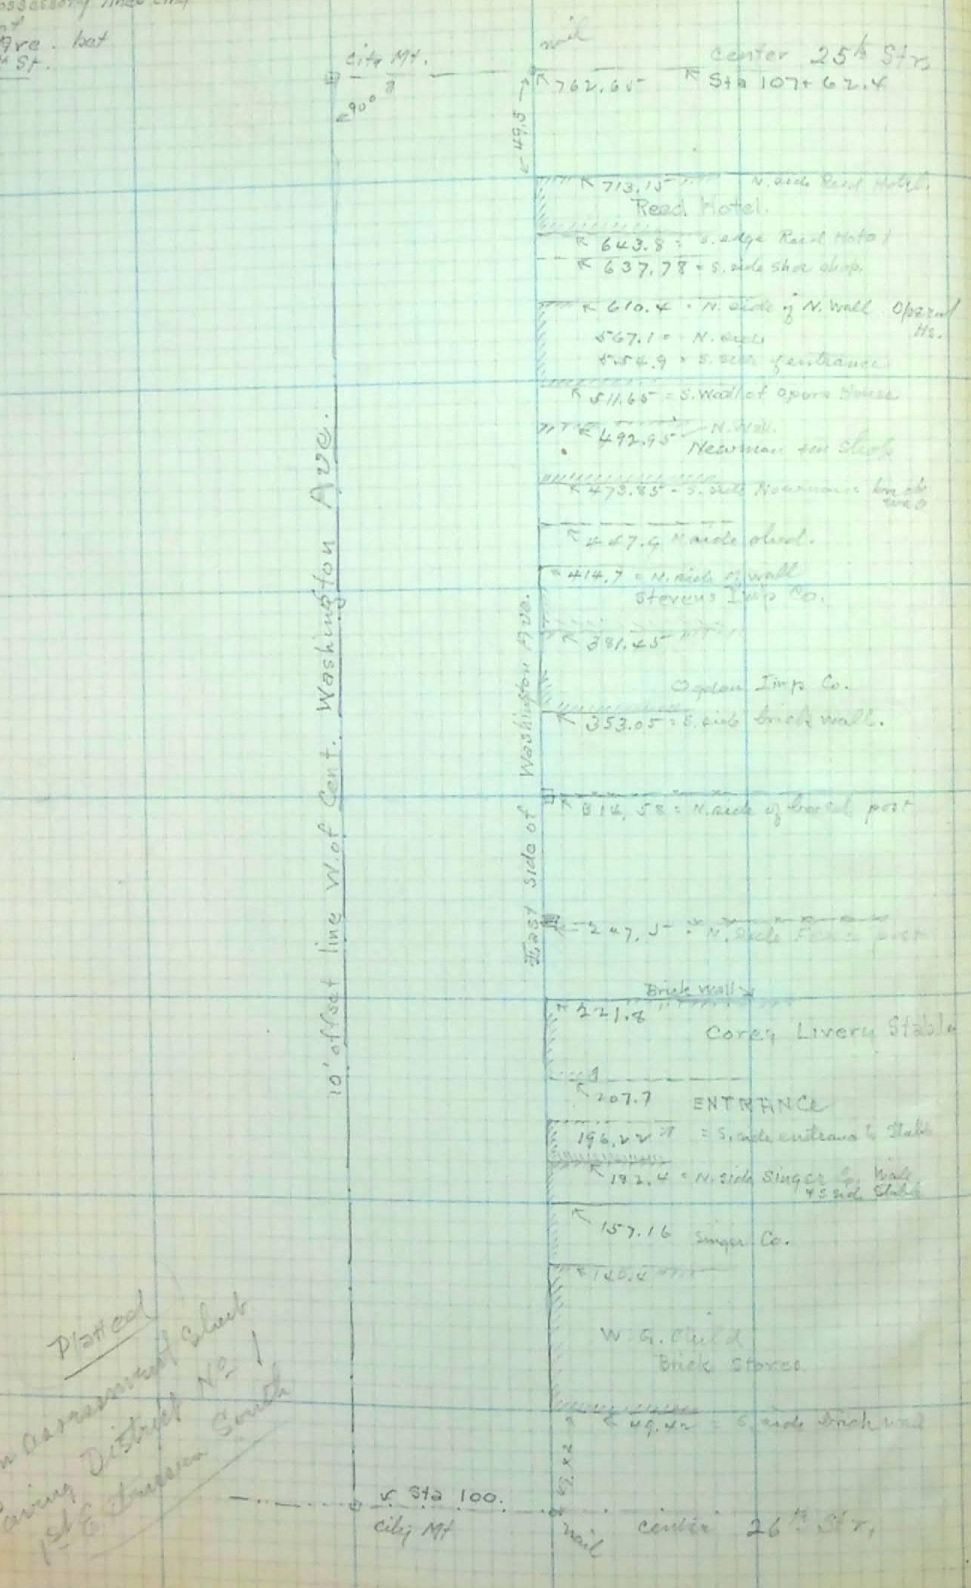
Notes of location of passageway lines and buildings on E. side of Washington Ave. bet 25th & 26th Sts.