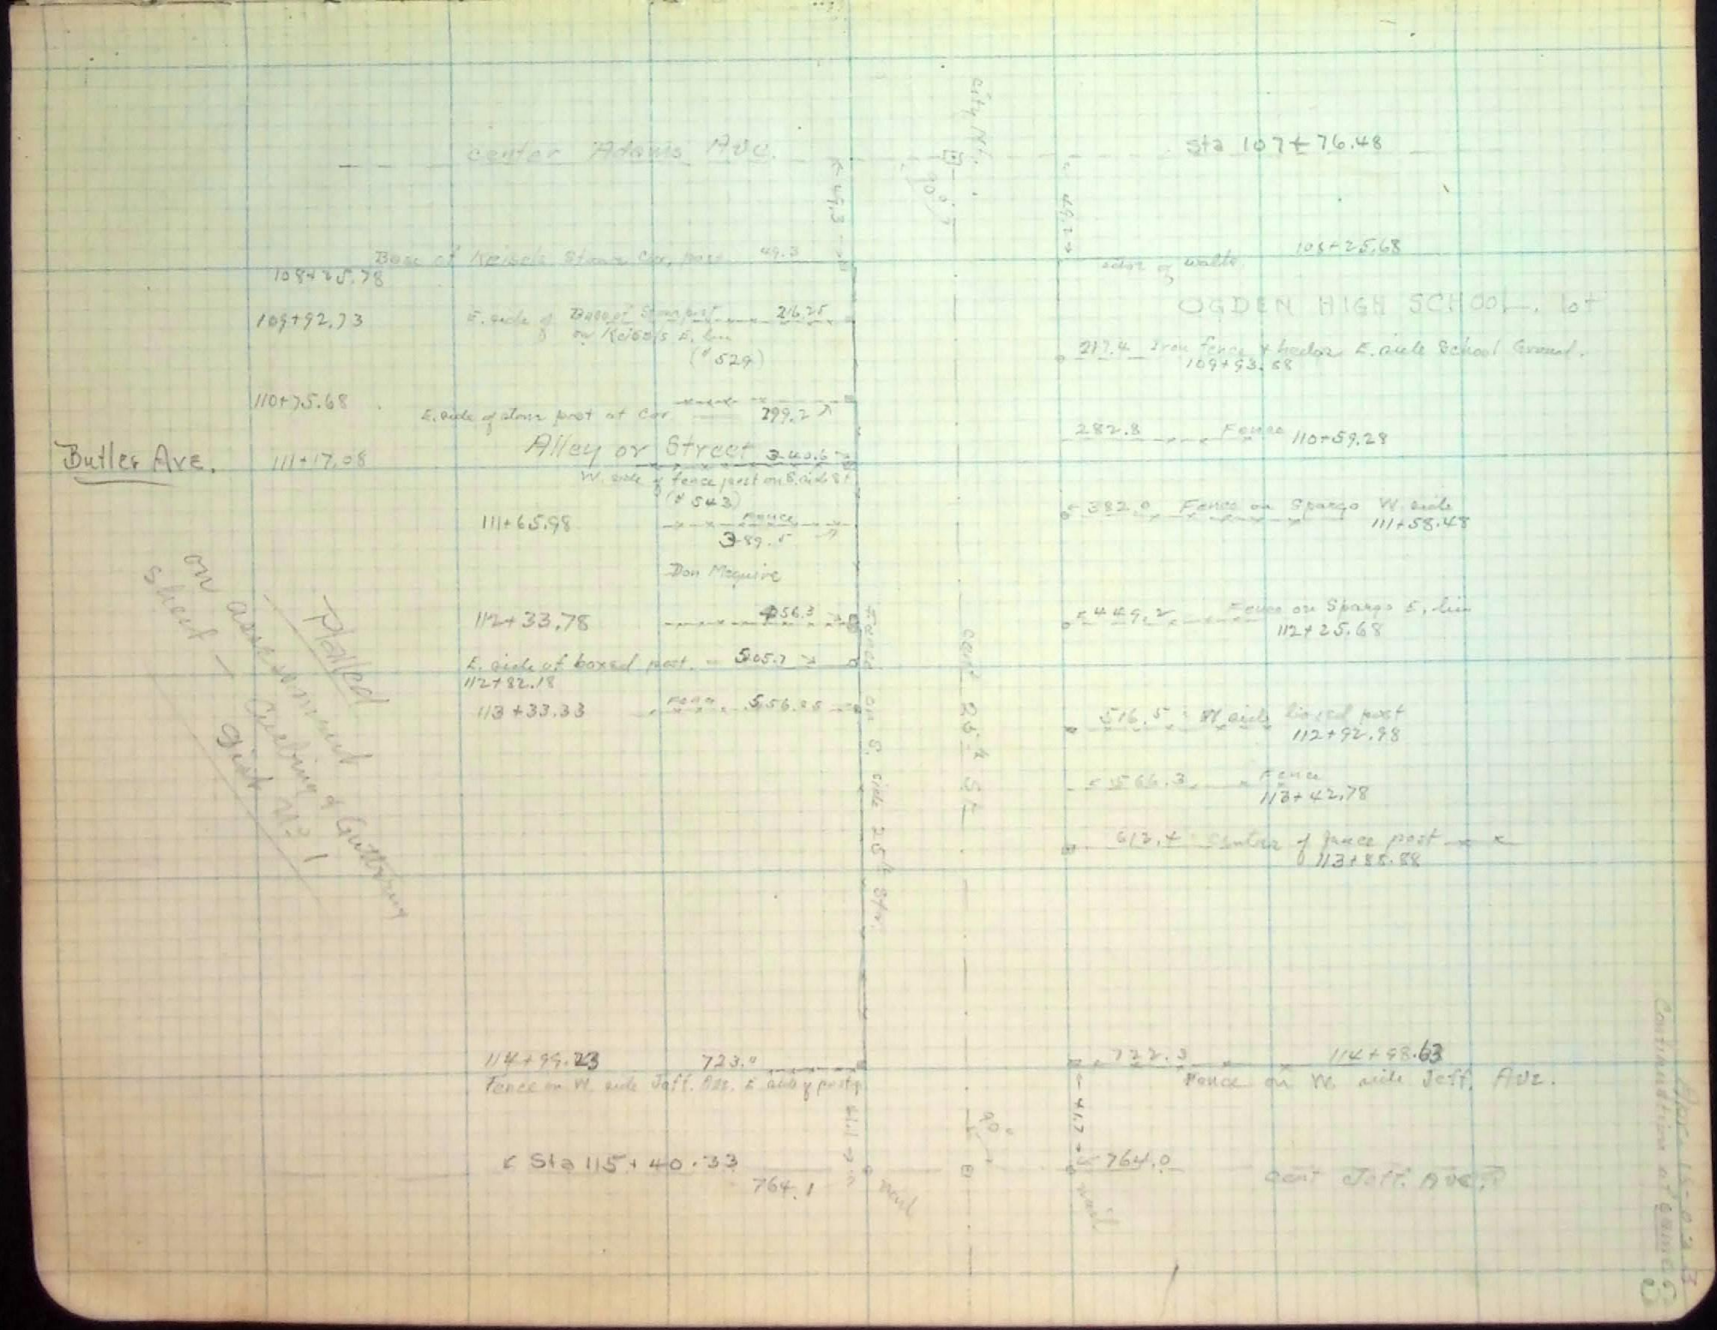
Center Adams Ave.
Sta 107+76.48
Base of Reiser Stone Cor, Bore 49.3
108+05.78
108+28.68
edge of walk
109+92.73
E. side of Base of Stone post & on Reiser's E. line (#529) 216.75
OGDEN HIGH SCHOOL, lot
217.4 Iron fence & hedge E. side School Ground. 109+93.58
110+15.68
E. side of stone post at Cor 299.2
282.8 Fence 110+59.29
Butler Ave.
111+17.08
Alley or Street 340.6
W. side of fence post on E. side St. (#543)
382.0 Fence on Spargo W. side 111+58.48
111+65.98
Fence 389.5
Don Maguire
112+33.78
456.3
E. side of boxed post 505.7
112+82.18
Fence 556.85
113+33.33
449.2 Fence on Spargo E. line 112+25.68
516.5 W side boxed post 112+92.98
Fence 113+42.78
613.4 S. line of fence post 113+85.58
114+99.23
723.0
Fence on W. side Jeff. Ave. E. side y post
727.3
114+98.63
Fence on W. side Jeff. Ave.
Sta 115+40.33
764.1
764.0
cent Jeff. Ave.