


Apr 16, 1903
Continuation of same notes.

Remains same Jan 31 1903

cont Adams Ave.

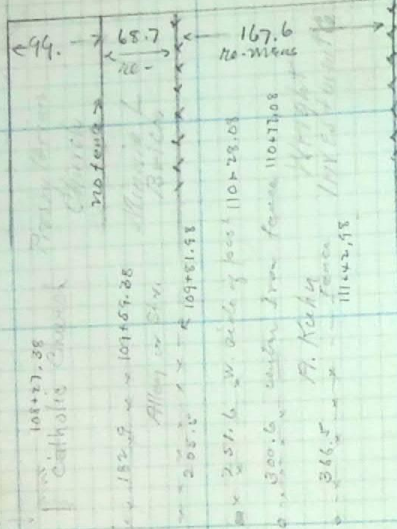


24th Street

Sta 107+76.48

Presbyterian church

Fence on S side of str.

Placed
on assessment sheet
curbing & outlining
District No. 3

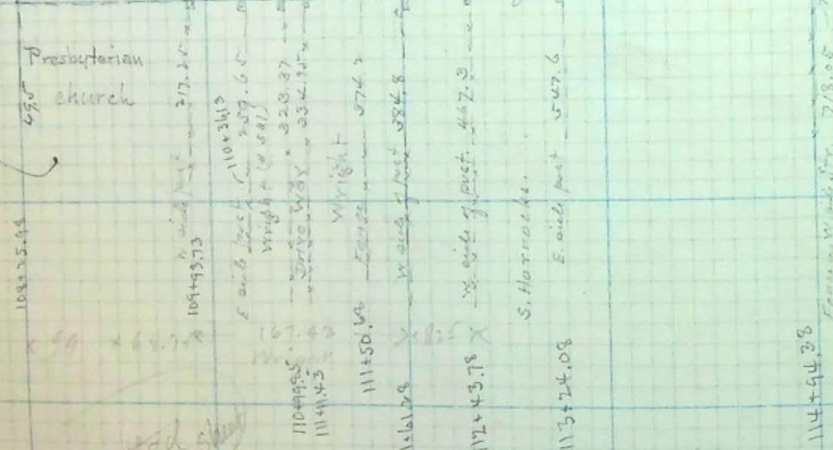

Sta 115+40.33