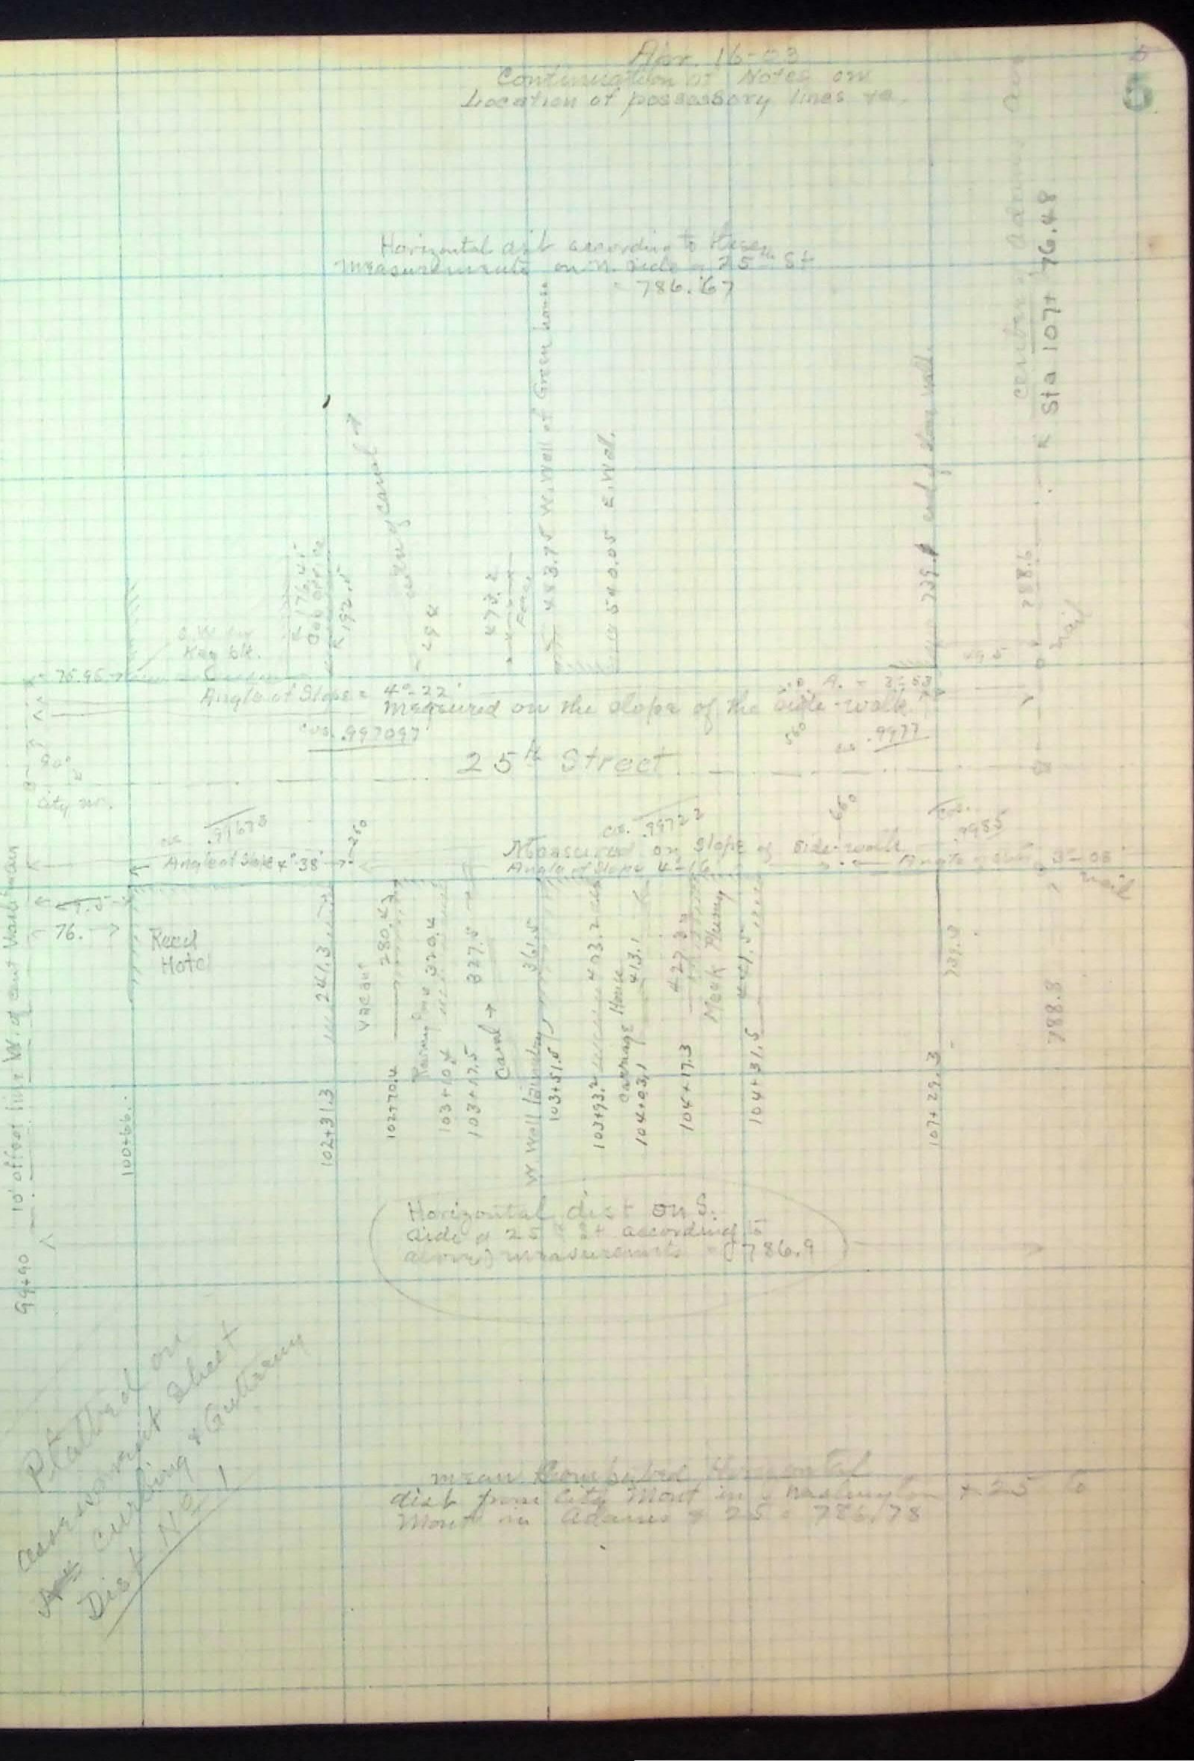Plan. 16-23
Continuation of Notes on
Location of possessory lines &c.