6

April 16-1903

Continuation of note on possessory lines &c.

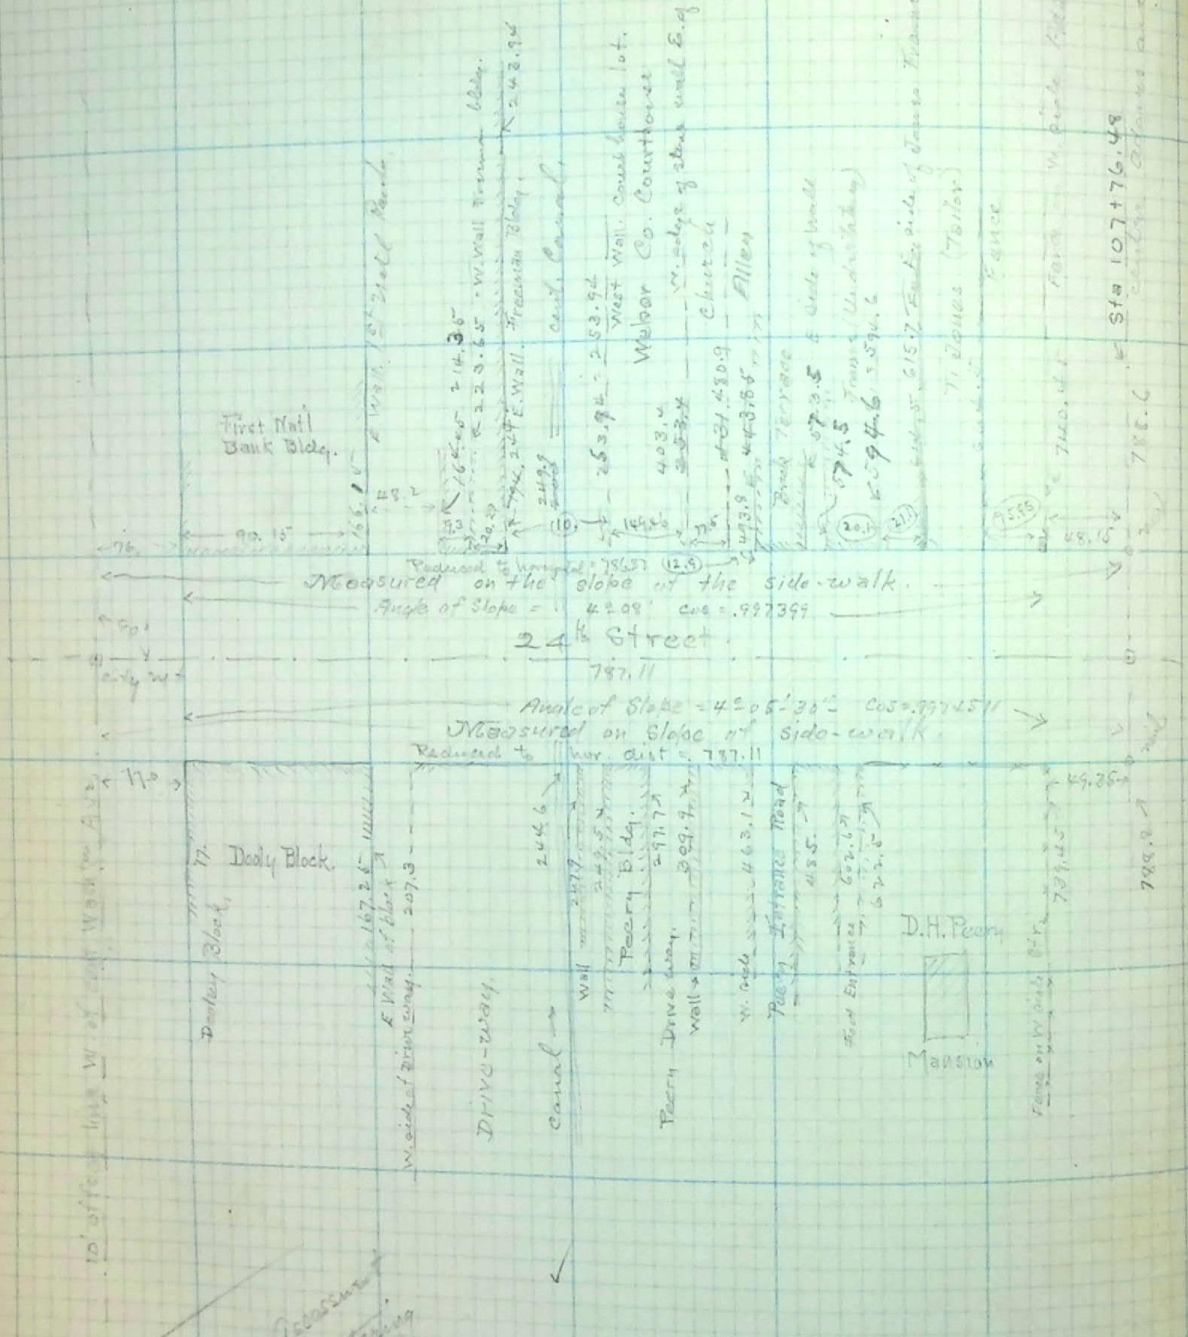

Platted on Assessment sheet, Curbing & Guttering District No 3