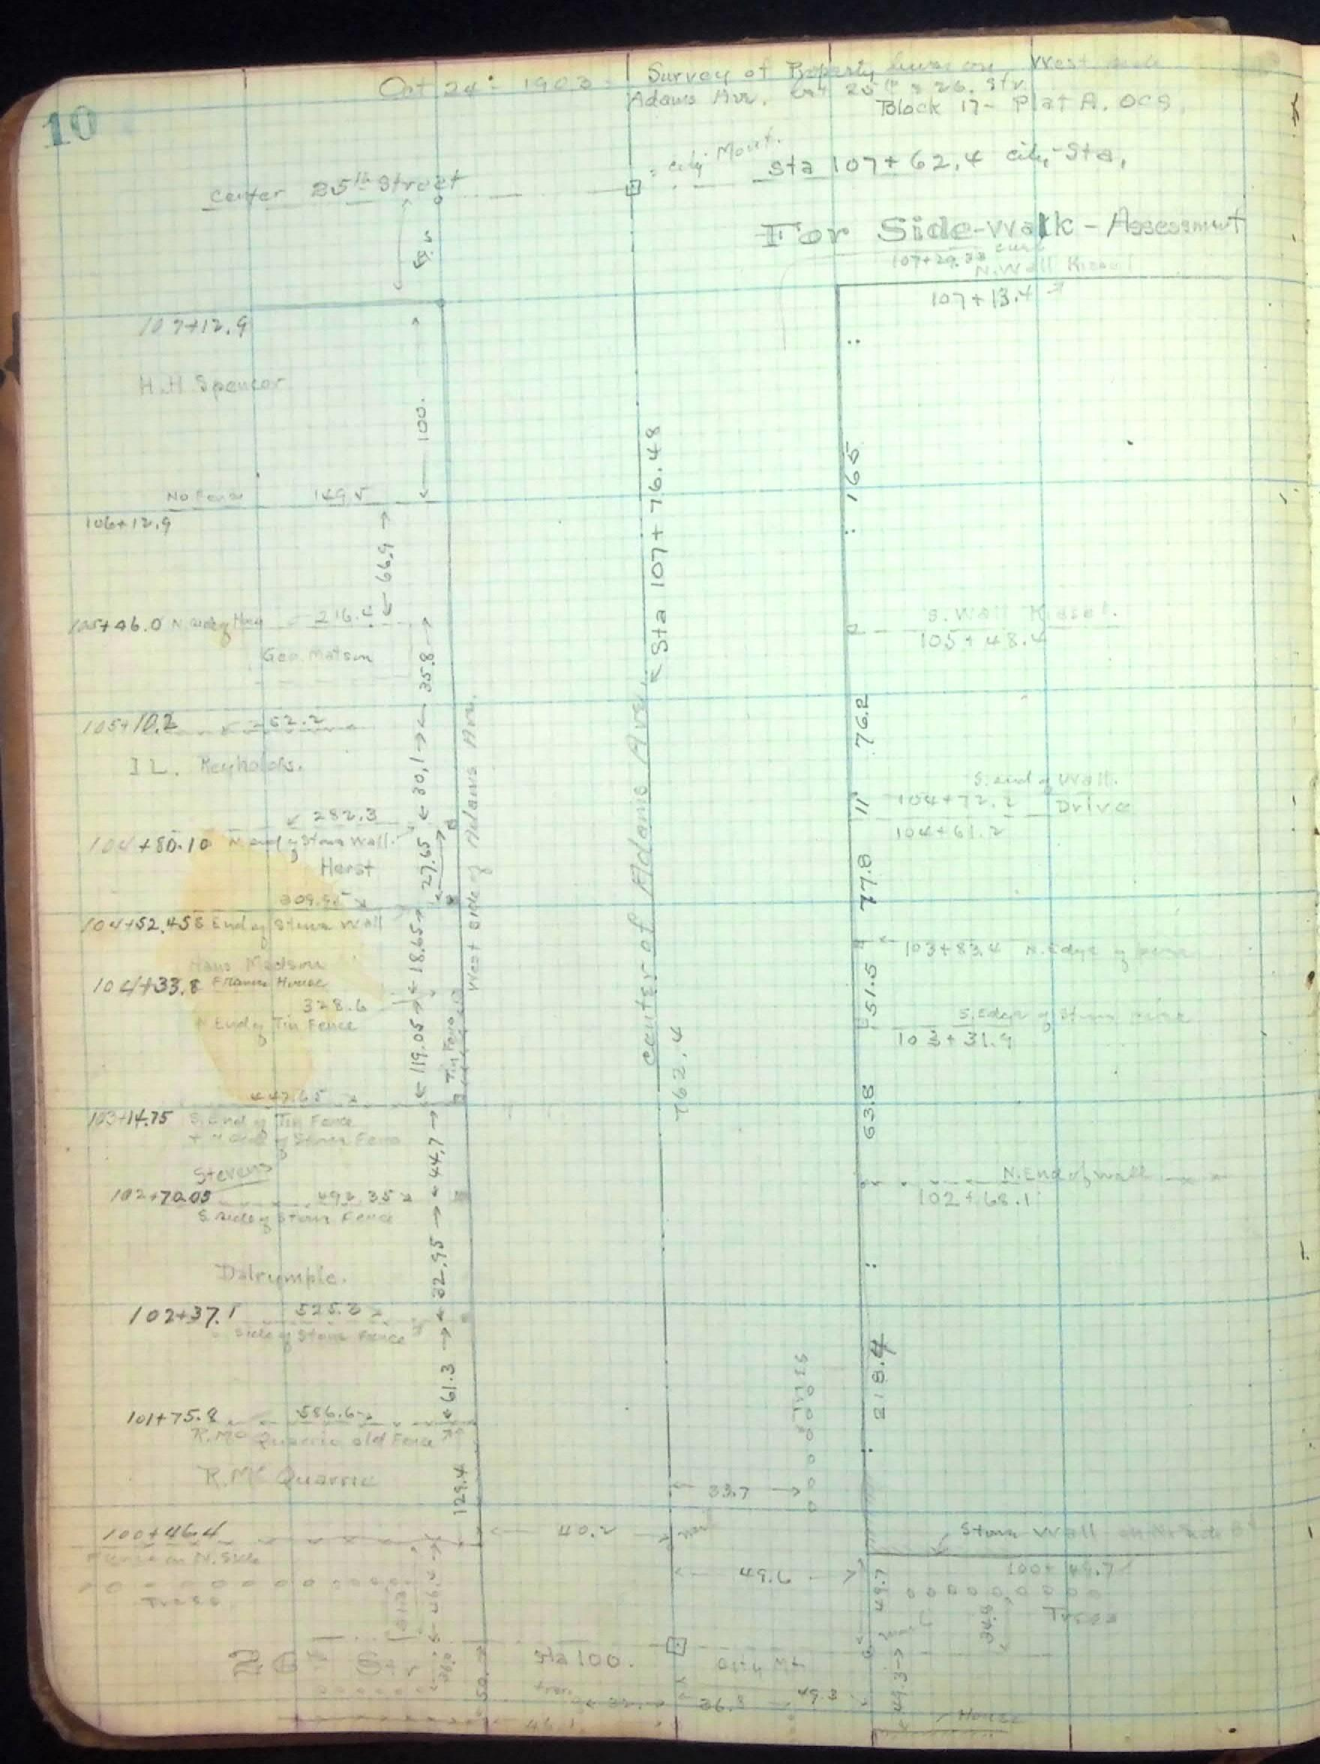
10
Oct 24 - 1903
Survey of Property lines on West side
Adams Ave. Lot 25th & 26. Str.
Block 17 - Plat A. OCS.
Center 25th Street
= city Mont.
Sta 107+62.4 city Sta.
For Side-walk - Assessment
107+29.33 curb
N. Wall Kissel
107+13.4
107+12.9
H.H. Spencer
100.
No Fence
149.5
106+12.9
66.9
105+46.0 N. side of House
216.4
Geo. Matson
35.8
105+10.2
252.2
I.L. Reynolds.
282.3
104+80.10 N. end of Stone Wall
Herst
27.65
309.95
104+52.45 S. End of Stone Wall
Hans Madsen
104+33.8 Frame House
328.6
N. End of Tin Fence
18.65
119.05
Tin Fence
West side of Adams Ave.
Center of Adams Ave.
Sta 107+76.48
762.4
165
S. Wall Kissel.
105+48.4
76.2
S. end of Wall.
104+72.2
Drive
104+61.2
77.8
103+83.4 N. Edge of Fence
51.5
S. Edge of Stone Fence
103+31.9
63.8
N. End of wall
102+68.1
447.65
103+14.75 S. End of Tin Fence
+ N. end of Stone Fence
Stevens
102+70.05
492.35
S. side of Stone Fence
44.7
32.95
Dalrymple.
102+37.1
525.3
S. side of Stone Fence
61.3
101+75.8
586.6
R. McQuarrie old Fence
R. McQuarrie
129.4
33.7
218.4
100+46.4
Fence on N. Side
Trees
40.2
49.6
Stone Wall on N. Side
100+49.7
Trees
26th Str
Sta 100.
City Mt.
36.8
49.3
House