


Feb. 12 - 1904

25th Str.

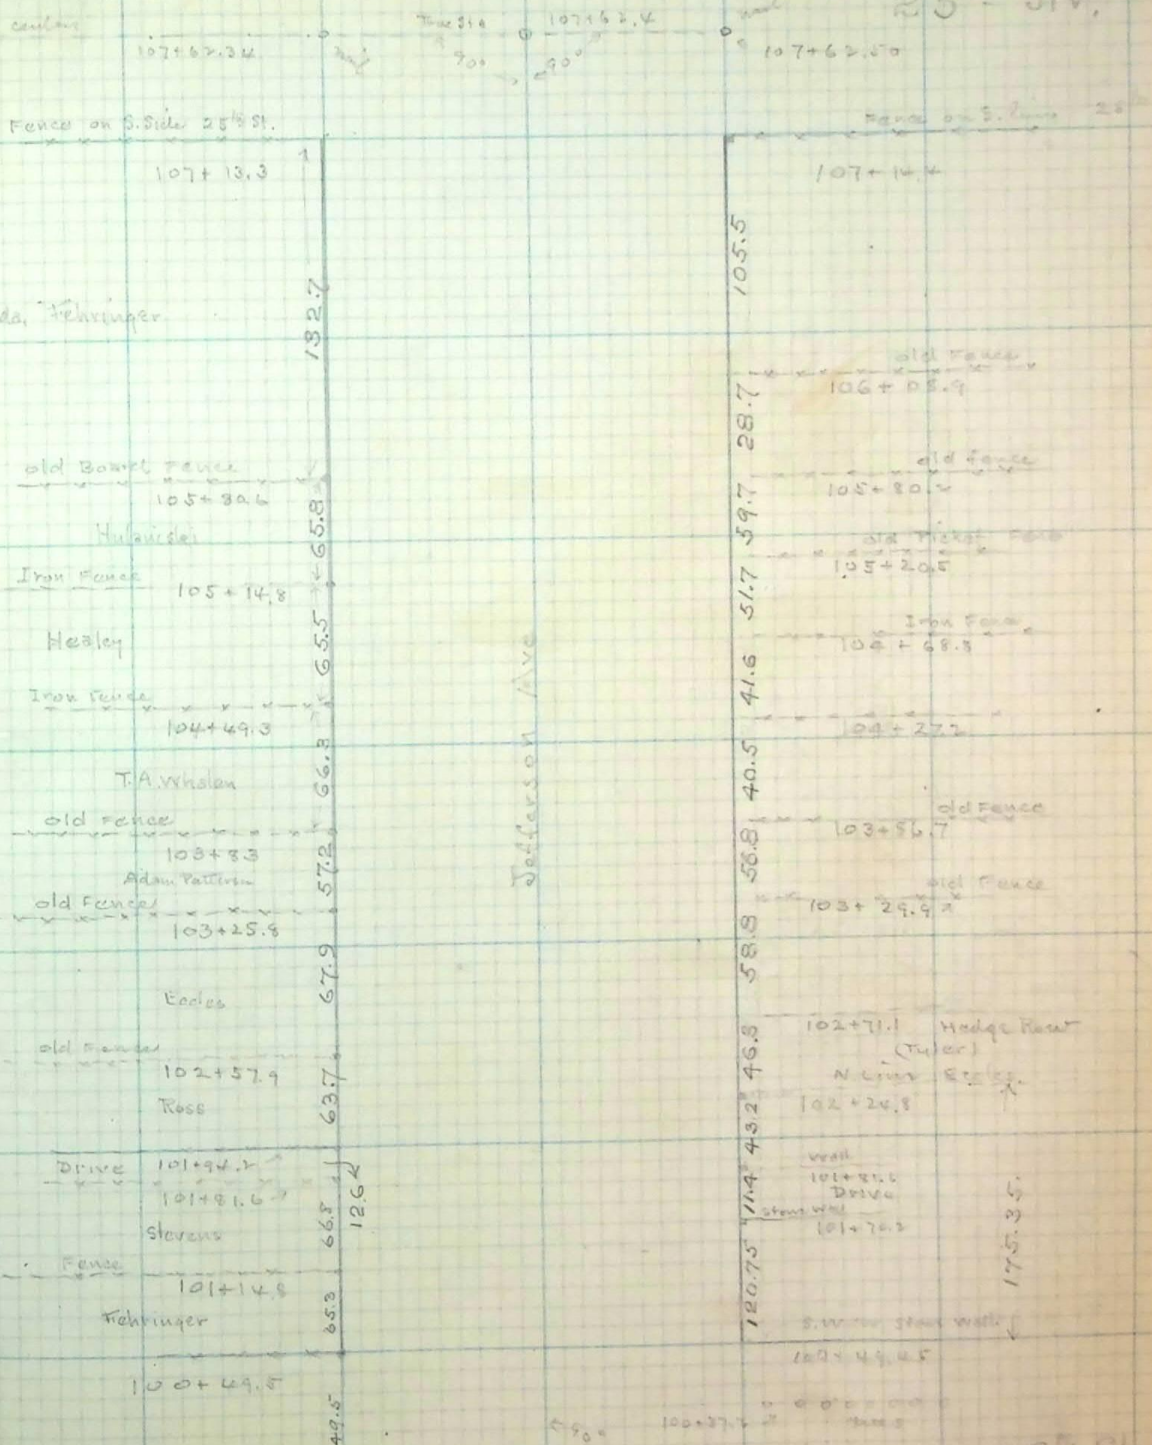

center
107+62.34

107+62.4
107+62.50

Fence on S. Side 25th Str.
107+13.3

107+14.4

Ira Fehring

old Boxed Fence
105+34.6

Iron Fence
105+14.8

Iron Fence
104+49.3

old fence
103+83

old fence
103+25.8

old fence
102+57.9

Drive
101+94.2
101+81.6

Fence
101+14.8

100+49.5

132.7
65.8
65.5
66.3
57.2
67.9
63.7
66.8
65.3
49.5

Jefferson Ave

105.5
28.7
59.7
51.7
41.6
40.5
56.8
58.8
46.8
43.2
114
120.75

old fence
106+08.9
old fence
105+20.5
old fence
105+20.5
Iron Fence
104+48.3
104+27.7
old fence
103+86.7
old fence
103+29.9
102+71.1
102+24.8
101+81.6
101+70.2
100+49.5

175.25

City Sta. 100

City Mont. Cent. Rail
26th + Jeff.

26th Str.