Feb 14 -

14

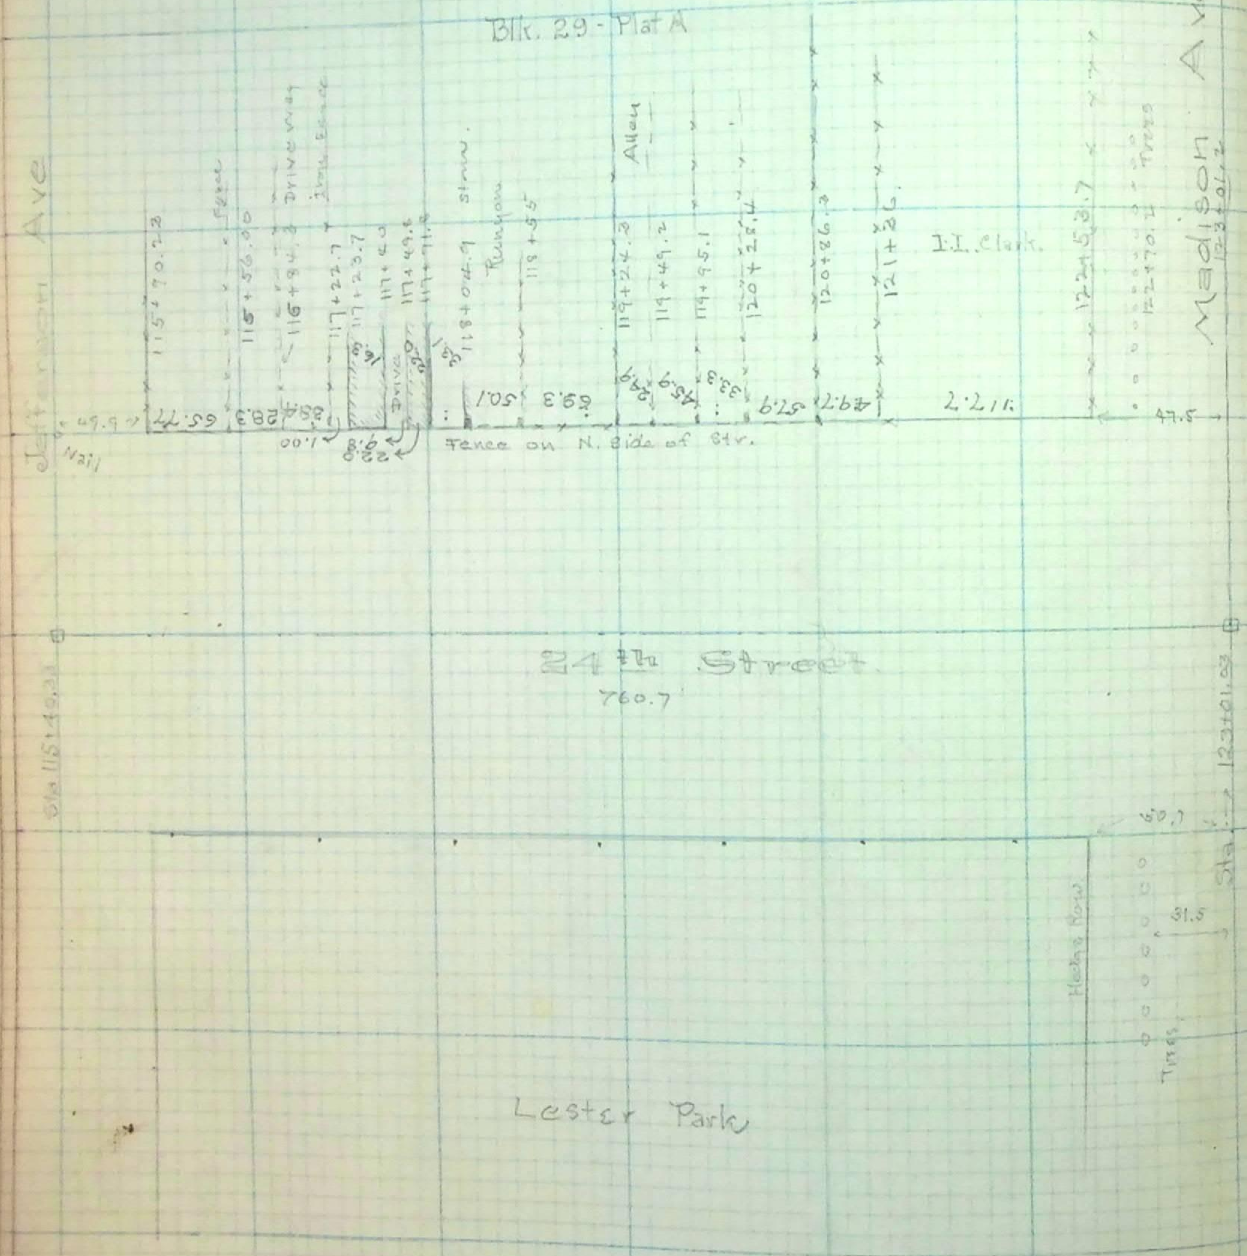

Blk. 29 - Plat A
Jefferson Ave
Madison Ave
Fence
Drive Way
Iron Fence
Drive
Stairs
Runyon
Alley
I.I. Clark
Trees
Fence on N. Side of Str.
24th Street
760.7
Lester Park
Hedge Row
Trees
Sta 115+49.33
Sta 123+01.03