


Diagram of offset lines for C. & G. Dists.
 1st Ex. E. to 3 No 5 } Notice Intention of Jan 4/1904
 2nd " " " 1 " 6 } (Mch 9th 1904)

1st Ex. E. to No. 3.

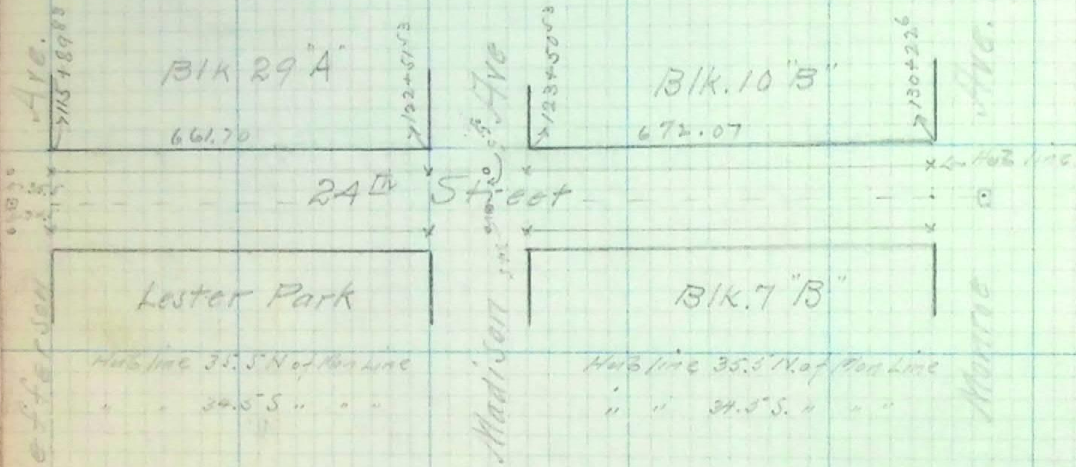

2nd Ex. E. to No. 1

