



113+27.8
113+27.8
Street 115+27.94
113+27.34 113+27.6

Jenkins
Snow
April 18-04

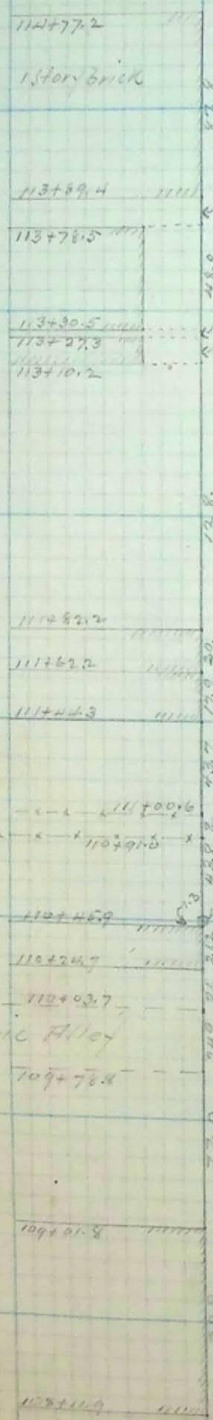


No correction on this side

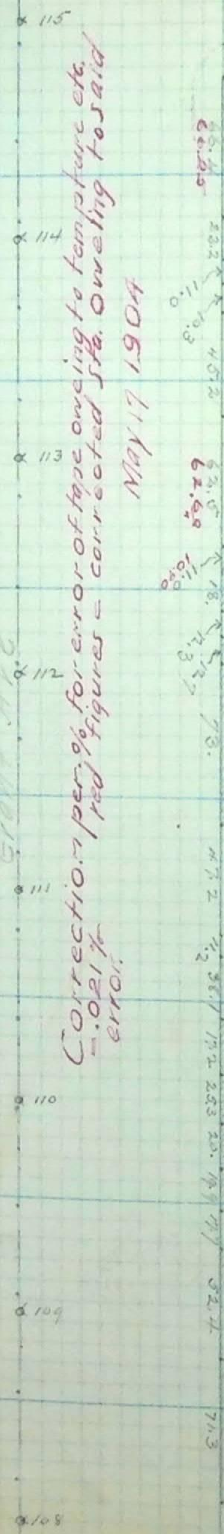

Correction per % for error of tape owing to temperature etc.
= .021 % error.

May 17 1904

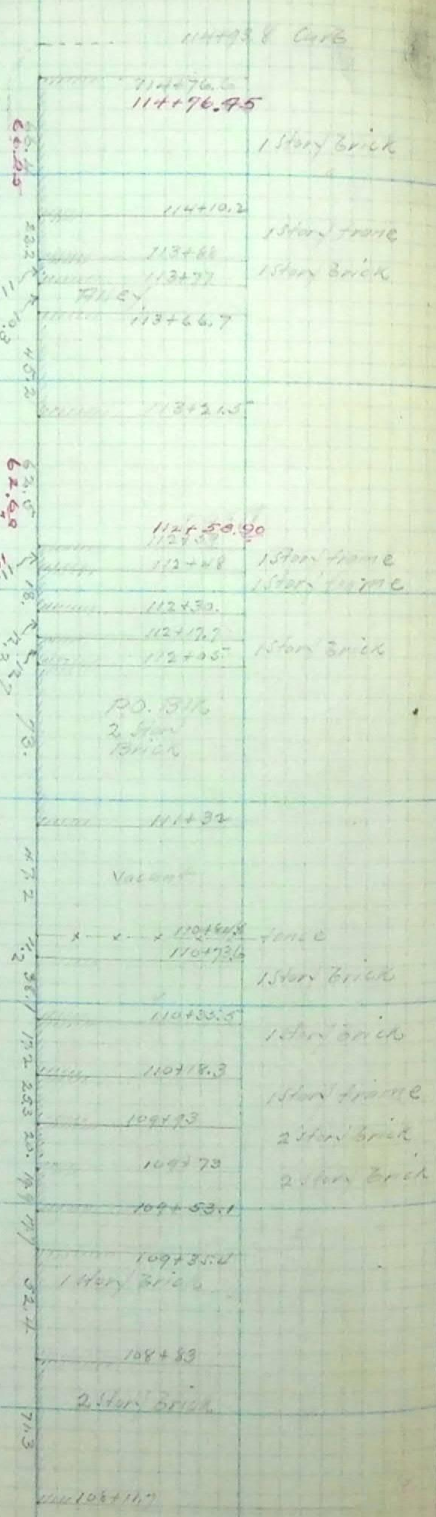

355

Street
107+62.4