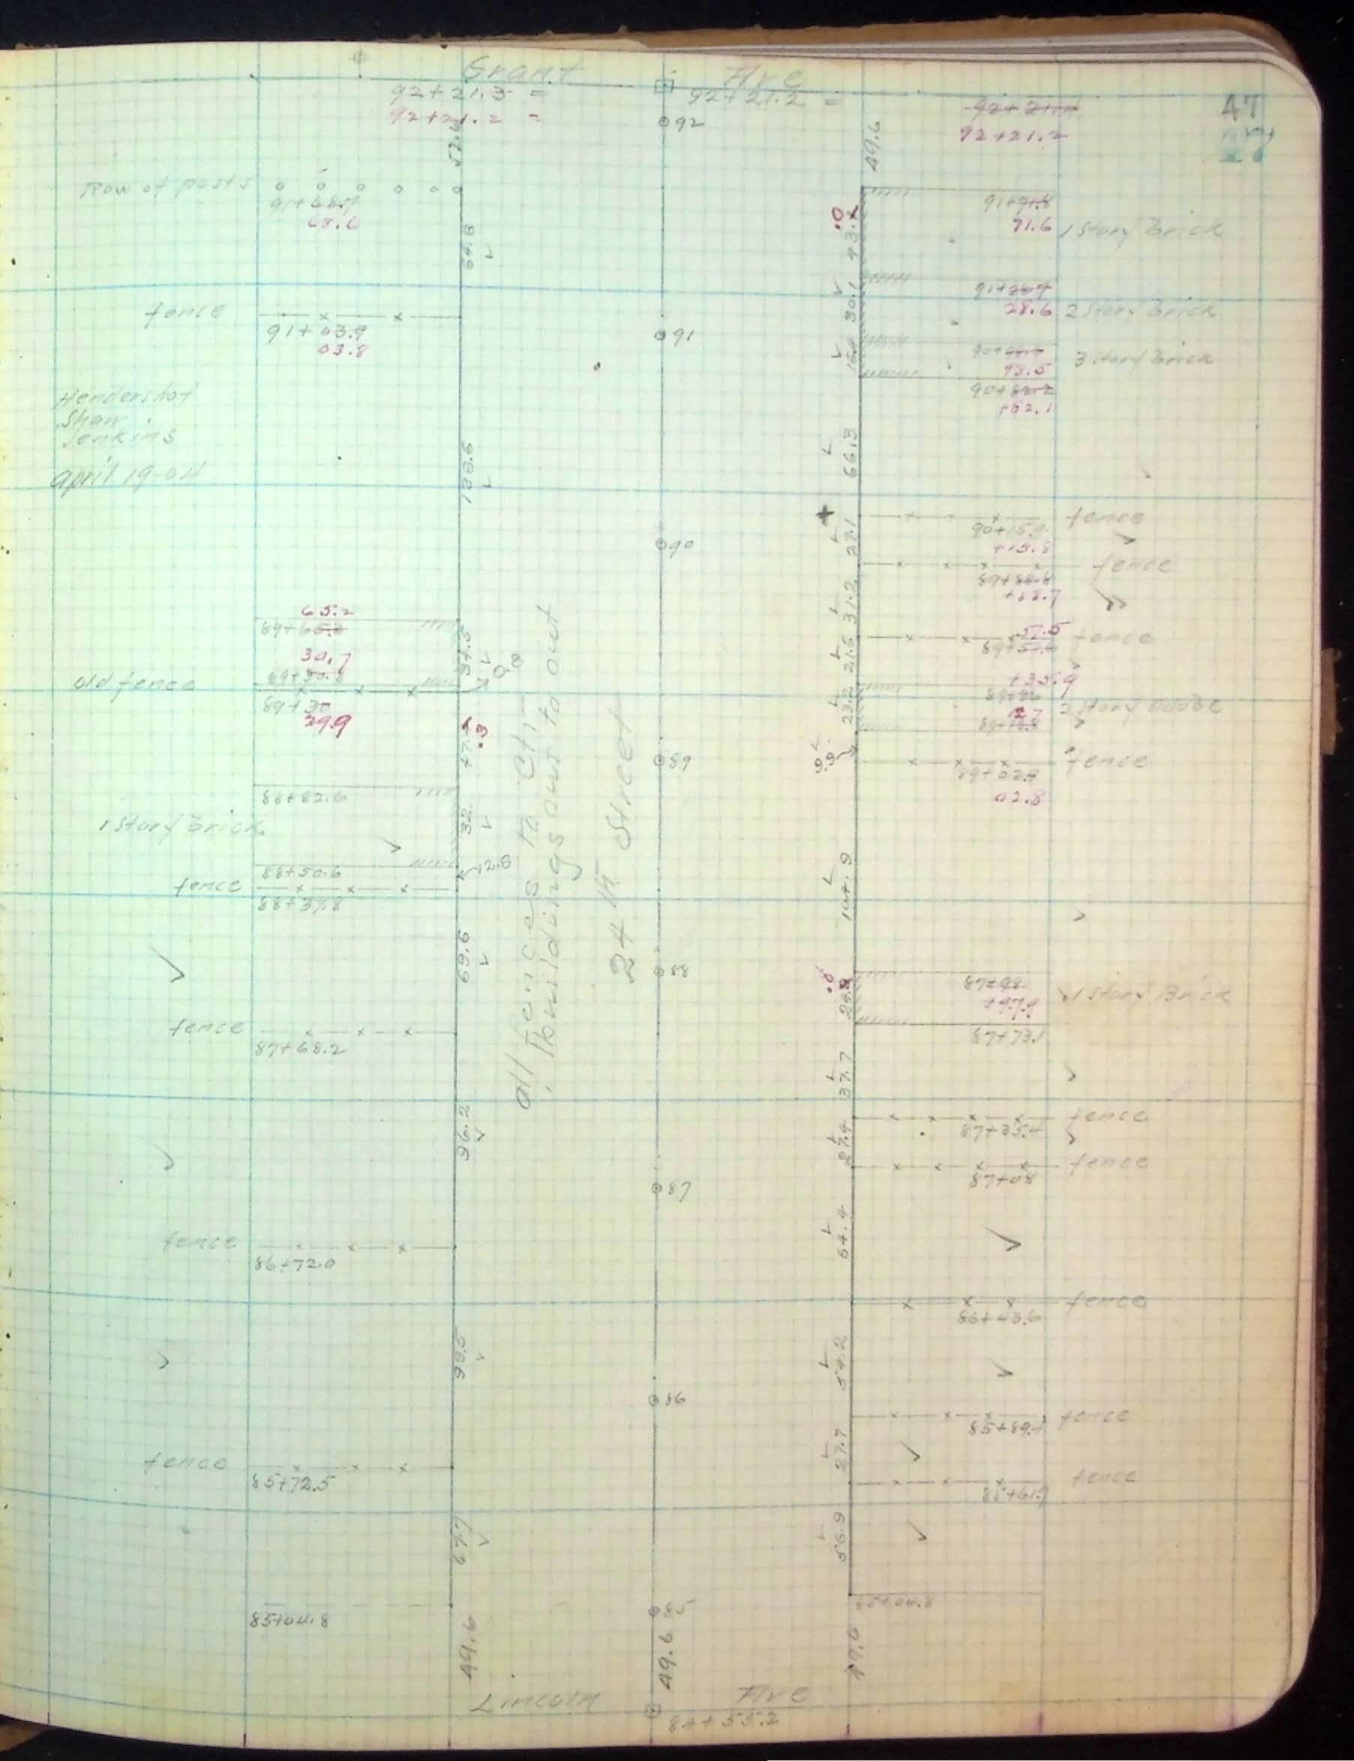
Grant Ave
92+21.3
92+21.2
92
91
90
89
88
87
86
85
Row of posts
91+68.7
68.6
fence
91+03.9
03.8
Henderson
Shaw
Jenkins
April 19-04
old fence
69+30
39.9
1 Story Brick
fence
88+30.6
88+37.8
fence
87+68.2
fence
86+72.0
fence
85+72.5
85+04.8
All fences to adjoin, Buildings set to out
24th Street
Lincoln Ave
84+53.2
49.6
47
91+91.5
71.6
1 Story Brick
91+29.7
28.6
2 Story Brick
90+77.9
73.5
3 Story Brick
90+52.2
52.1
fence
90+15.9
15.5
fence
89+82.6
82.7
fence
89+32.7
32.8
2 Story Adobe
89+22.7
22.8
fence
67+92.
47.9
1 Story Brick
87+73.1
fence
87+35.4
fence
87+08
fence
86+40.6
fence
85+89.1
fence
85+61.9
85+04.8