Monroe Ave
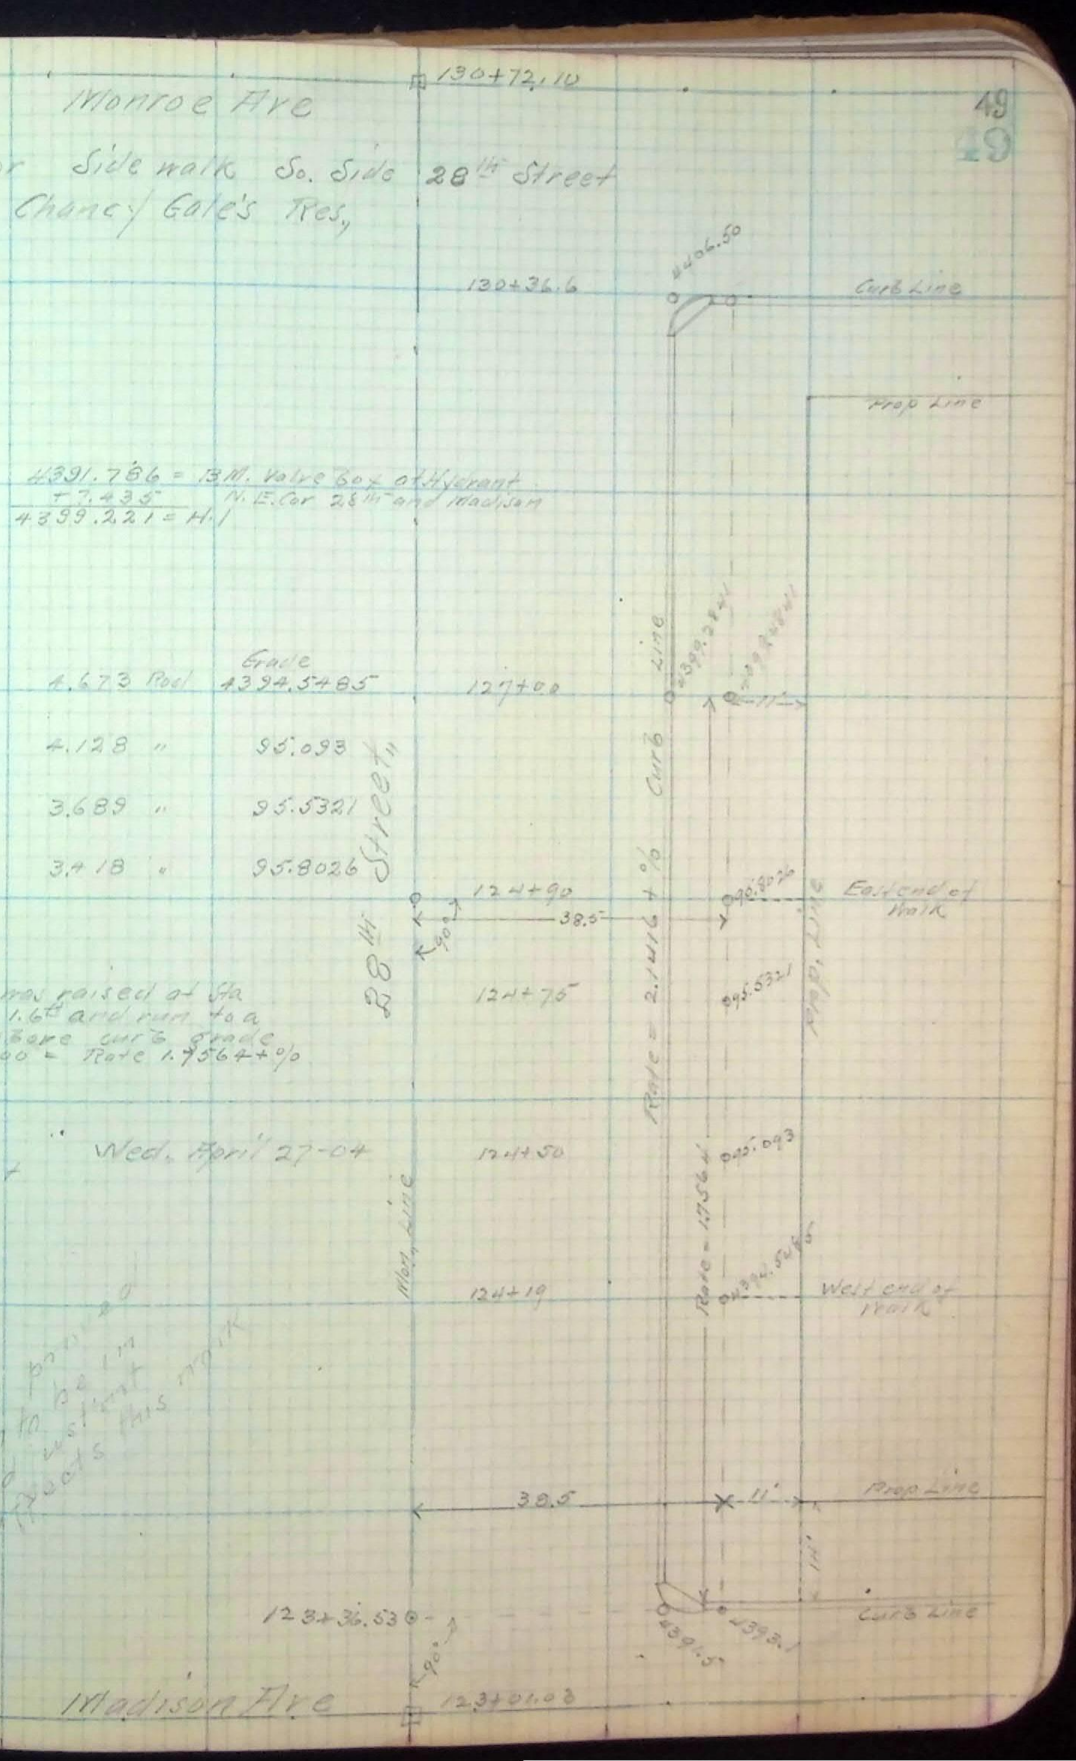
Grade for Side walk So. Side 28th Street
Chancy Gale's Res,