


50 Grades for Sidewalk E. Side Wall Ave
 bet. 25th St. and 26th St.

Laundry Bldg

25th Street 107+62.4




4302.177 B.M. Murphy Store
 + 3.143
 4305.320 H.I.

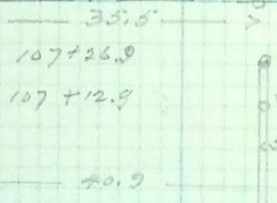

- Sta 104+16.6 = 5.4 E. of curb 4300.713 = 11 above curb grade
- " 104+31.5 = " " " 4300.753 = 11 " " "
- " 104+46.4 = " " " 4300.7184 = 11 " " "

Friday Apr. 29-04
 Leitz
 Jenkins
 Show

WALL AVE

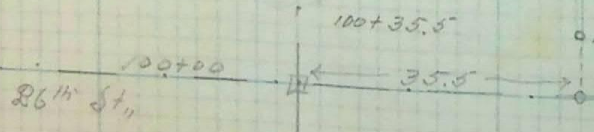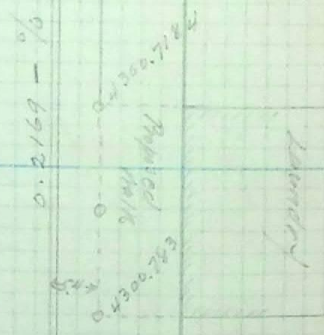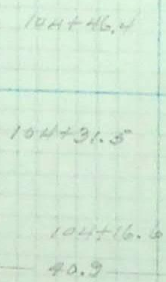

26th St.