


Grades on S Curb 23rd St, Bet. Washington & Adams
 222 and 232nd E. of E Prop Line of " "

Washington St

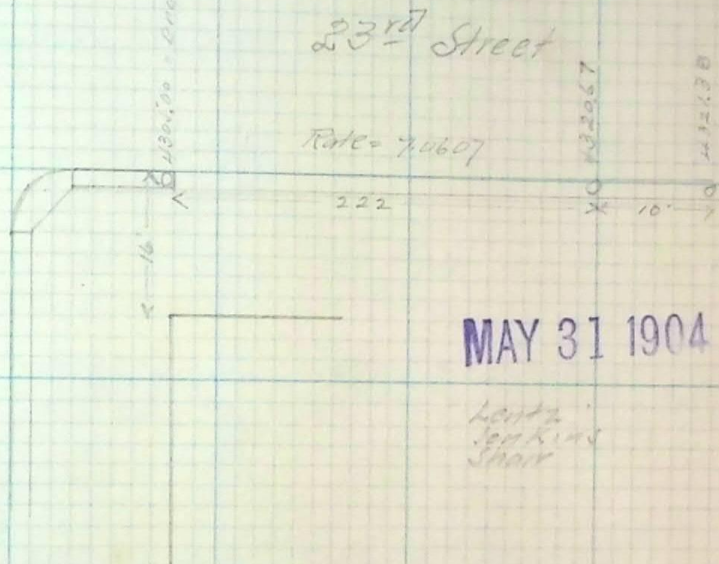

MAY 31 1904

Lantz
 Jan King
 Shair

4305.407 = 311.122 p.m. of Stone Mill N. Window
 + 5.325
 Care Drug Store

4310.73 H. 1

- 5.75 =

4305.00 = E end of old curb S.E. Cor Washington
 and 23rd St

- 1.27

T.P. 4309.26

+ 14.88

4324.14

- 2.47

4321.67

+ 6.10

4327.77

3.50

4320.67 = 222nd E of E Prop Line Washington

27.9

4321.38 = 232 " " " " " " "