


JUN 2 1904

83

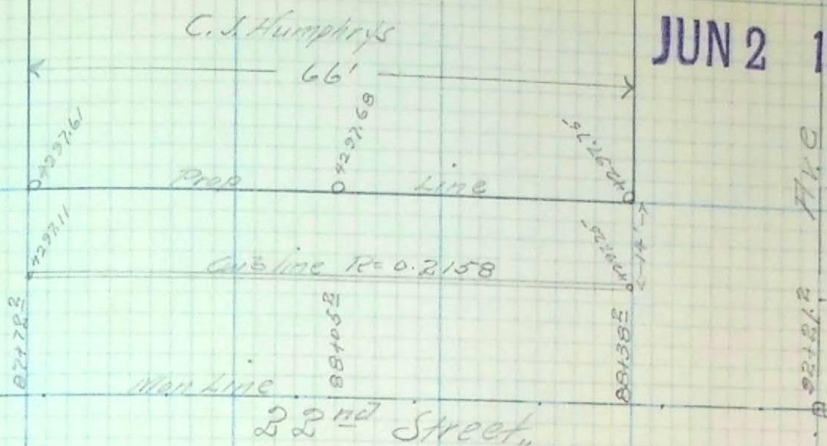

Grades for Side walk Hubs set on prop line
0.5 higher than curb elevations 14' walk

	4305.407	B.M. Care Drug Store
	+3.501	
	4309.208	
	-5.268	
T.P.	4303.246	
	+5.34	
	4309.186	
	-5.67	= 4303.516 B.M. Bertman Bldg 22 nd - walk -
	-5.79	
T.P.	4303.396	
	+1.81	
	4305.206	
	-6.484	= 4298.722 Mon 22 nd Grant Ave
T.P.	4298.722	
	+4.035	
	4302.747	Hil
Sta		N. Side
88438±	4.997	Grade of Prop
88405±	5.067	4297.75
87772±	5.137	4297.68
	4.025	4297.61
		4298.722 B.M. Mon, 22 nd Grant

Thurs June 2nd 04
Lent L
Jen Kern
Shair

Transferred from Private Book # 12