



JUN 22 1904

H.H.H.  
J.J. Vorley 85  
A.B. Griffith  
85

staked 11 ft out from  
prop line 0.2 higher  
than indicated

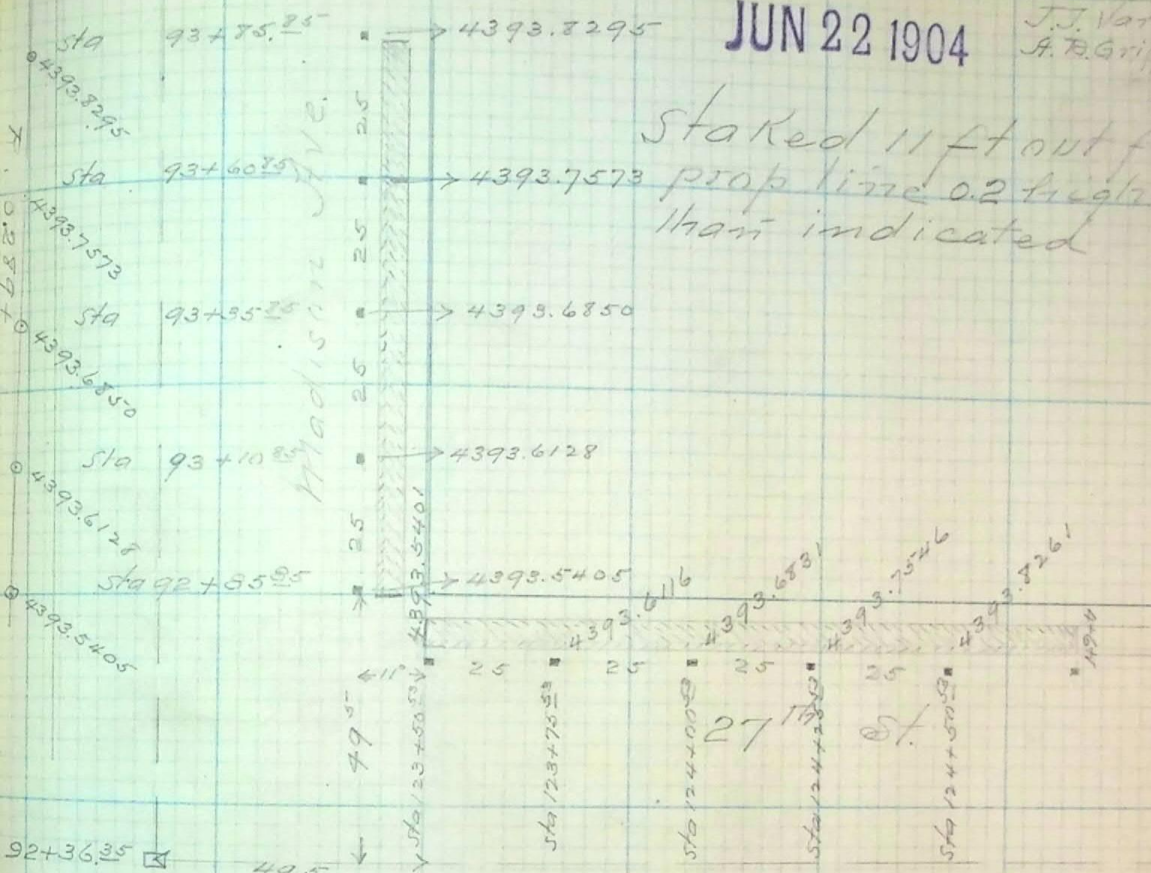

27th St

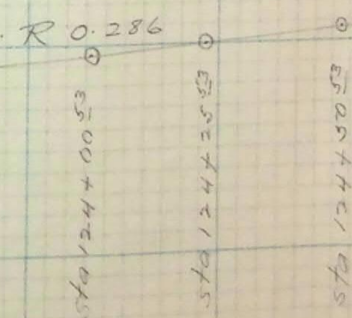

Prop line  
Sta 123+50.53 → 4393.5401

Sta 123+75.53 → 4393.6116

Sta 124+00.53

Sta 124+25.53

Sta 124+50.53