


Offset lines C. and G. Dist

June 24-04
 No 10
 H.H.H.
 J.J. Varley
 A.J. Griffith

Ave

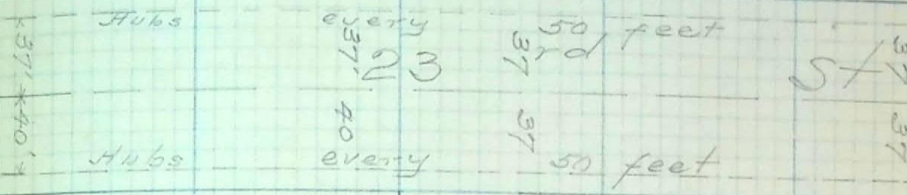


Wall

Line Ave

Grant Ave.

June 26-04

Grant Ave.

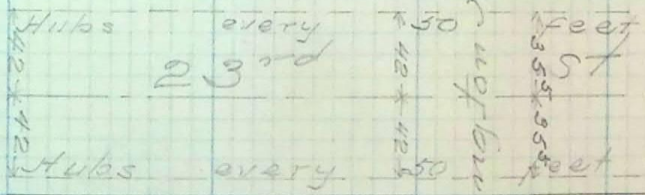


Ave. Washington Ave

Adams Ave

June 28-04

Adams Ave

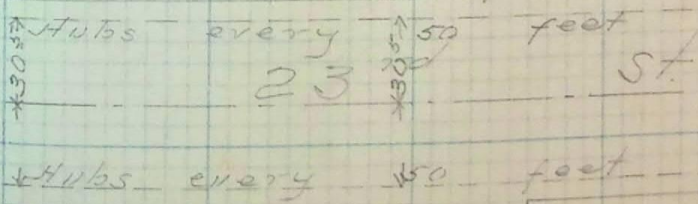

Jeff