


Cross-Section

Intersection  
Jefferson Ave and 24<sup>th</sup> Street

4372.933 Mon 24<sup>th</sup> - Jefferson  
 $\frac{47.867}{4377.790} = 1.1$

4372.933  
 $\frac{4.877}{4377.810} = 1.1$

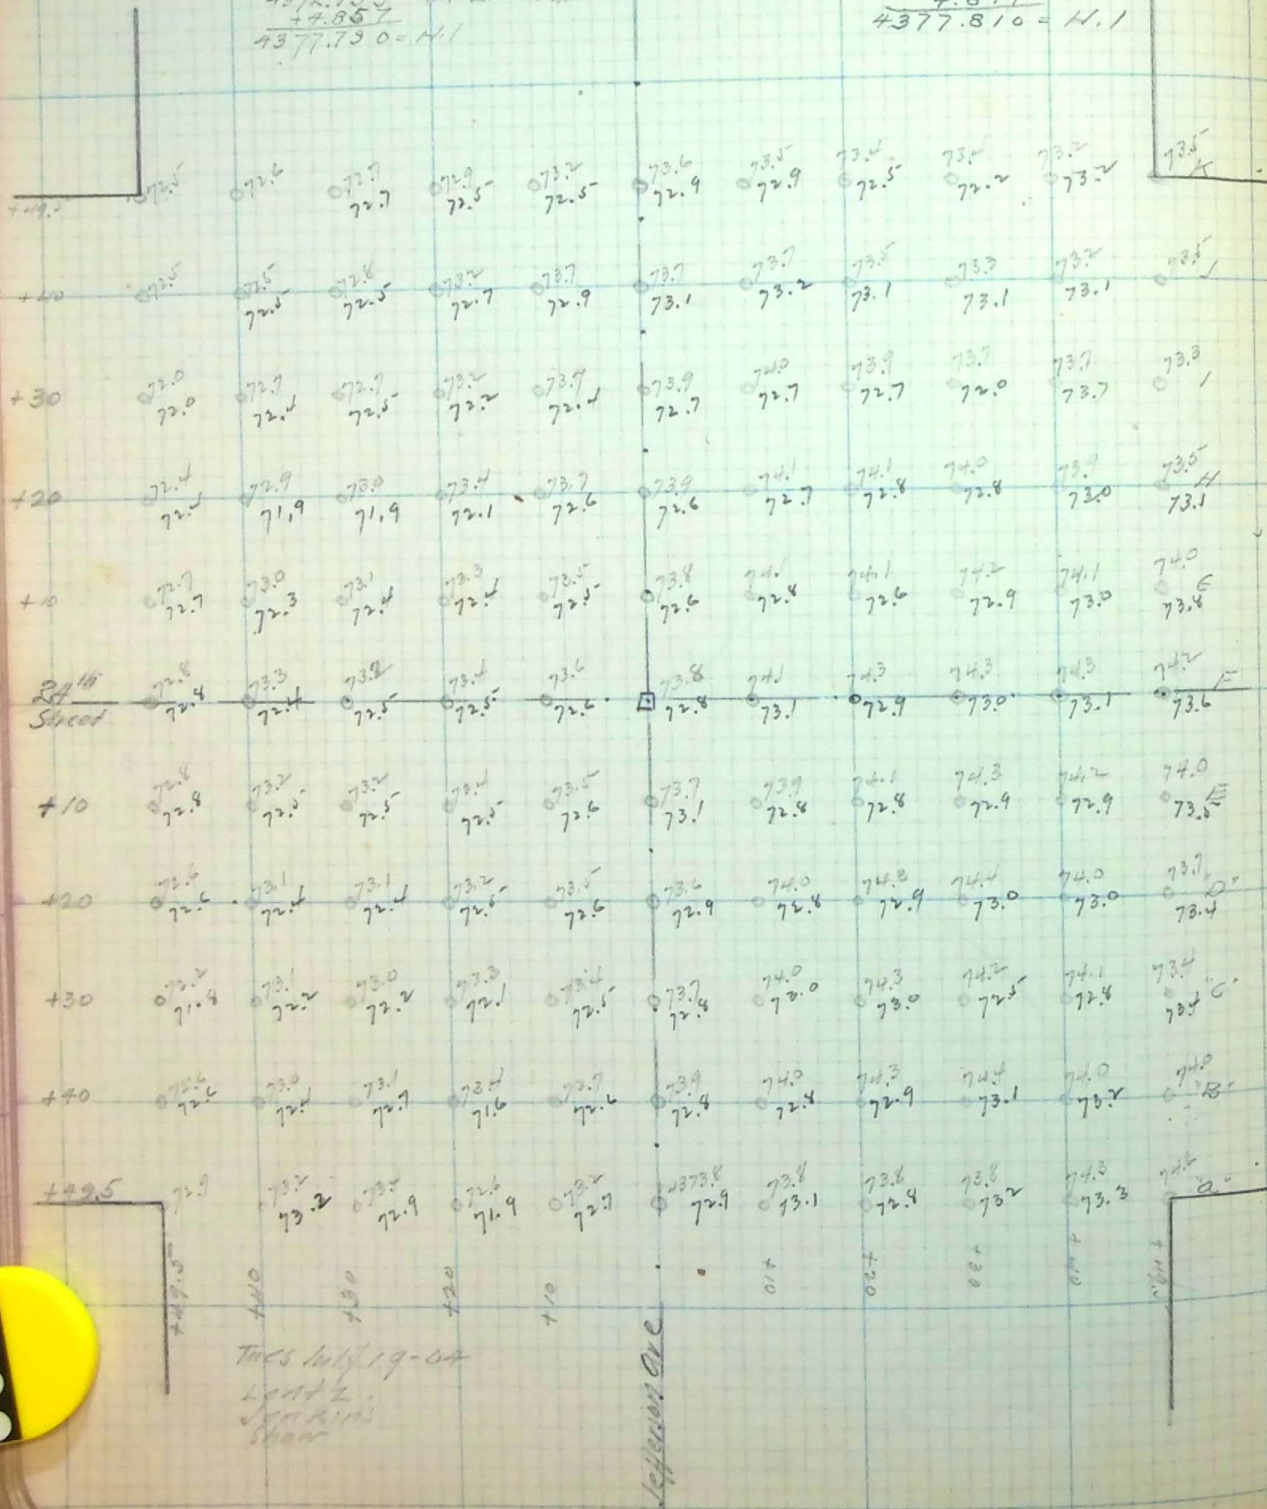

Tues July 19-04  
 East 2  
 Jefferson Ave