


Grades for Top of Gutter  
across Jefferson N Side 26<sup>th</sup> W.

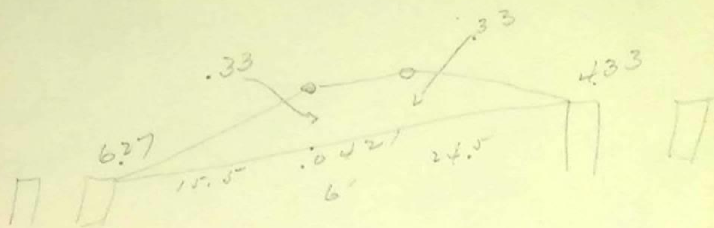

N Side

$$\begin{array}{r}
 6.27 \\
 - .60 \\
 \hline
 5.67 \\
 - .33 \\
 \hline
 5.34
 \end{array}$$

E Side

$$\begin{array}{r}
 4.33 \\
 + 1.03 \\
 \hline
 5.36 \\
 - .33 \\
 \hline
 5.03
 \end{array}$$

$$\begin{array}{r}
 0.571 - 5.851 \\
 \hline
 276.5 \\
 881.000
 \end{array}$$