


Grades and Location  
Scales City Hall Square

107+62.4

25th St

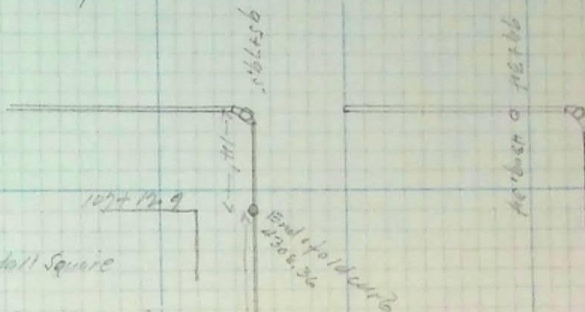

4311.535 NE Cor City Hall Square

+2.02  
4313.555  
-5.19

4308.365 end of old curb  
N. Side of Hudson  
S. " " 2.5 ft


-5.50  
4308.515 T.P.  
+0.30  
4313.515 H.H.

Curb  
Grade  
4309.71

102+24.9

3.805


102+24.9

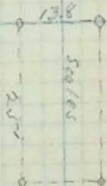

Hudson Ave  
100+00.00

100+40.5

2072.200 curb  
on 26th St

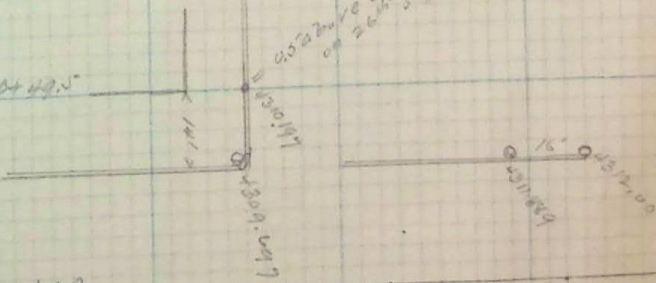

Lantz  
Jenkins  
Shaw

JUL 12 1904

100+00

26th St

Hudson Ave