


Sidewalk-Notes for Repairs.

Made by J.M. Lentz - Beginning Feb. 24-1904.


Prop lines
re-inteas
16.04
16.04
16.04
16.04

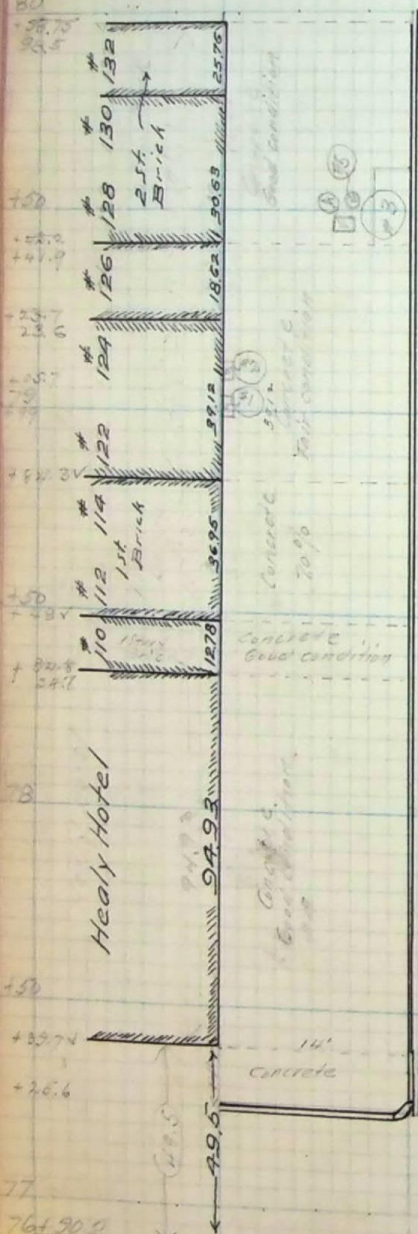

Healy Hotel

NOTE
All Figures except black
are void.

rate of error in tape
for South side = 0.0044%

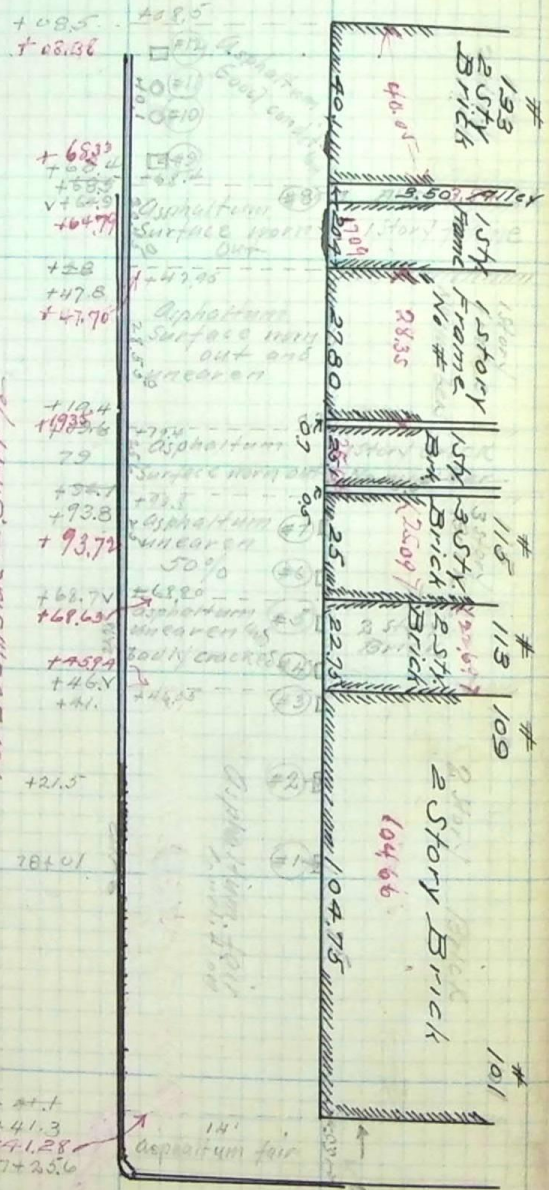

WALL FIVE

SOUTH SIDE 25th St.

- #1 = 78+01 W. end of Basement Ventilator 2.0 Wide 3.2 Long
- #2 = 78+21.5 " " " " " " " 2.0 " 3.2 "
- #3 = 78+47. " " " " " " " 2.0 " 3.2 "
- #4 = 78+79.5 " " " " " " " 1.3 " 2.4 "
- #5 = 78+60.3 " " " " " " " 1.3 " 2.4 "
- #6 = 78+71.5 " " " " " " " 2.0 " 3.2 "
- #7 = 78+84.4 " " " " " " " 2.0 " 3.2 "
- #8 = 78+64.9 1 side " Small Alley bet. Buildings 3.6 Wide
- #9 = 78+73. " " " Basement trap doors iron 3.5" wide 5.0 Long 1.5 from curb
- #10 = 78+84.7 Ctr of M.H. 2.0 dia 1.5 from curb
- #11 = 78+92.8 " " " " " " " " " " " " " " " "
- #12 = 78+99 W. side of Basement trap doors iron 3.5" wide 5.0 Long 1.5 from curb

NORTH SIDE 25th St.

- #1 = 78+39 W. end of Basement Ventilator 1.6 Wide 2.9 Long
- #2 = 78+05.7 " " " " " " " 1.6 " 2.9 "
- #3 = 78+42.2 " " " Strip of concrete next to curb 2.25 wide 16.3 Long should be replaced
- #4 = 78+44.3 W. " " iron trap doors to basement 4.0 wide 5.0 Long
- #5 = 78+53 Center of M.H. 2' Dia.