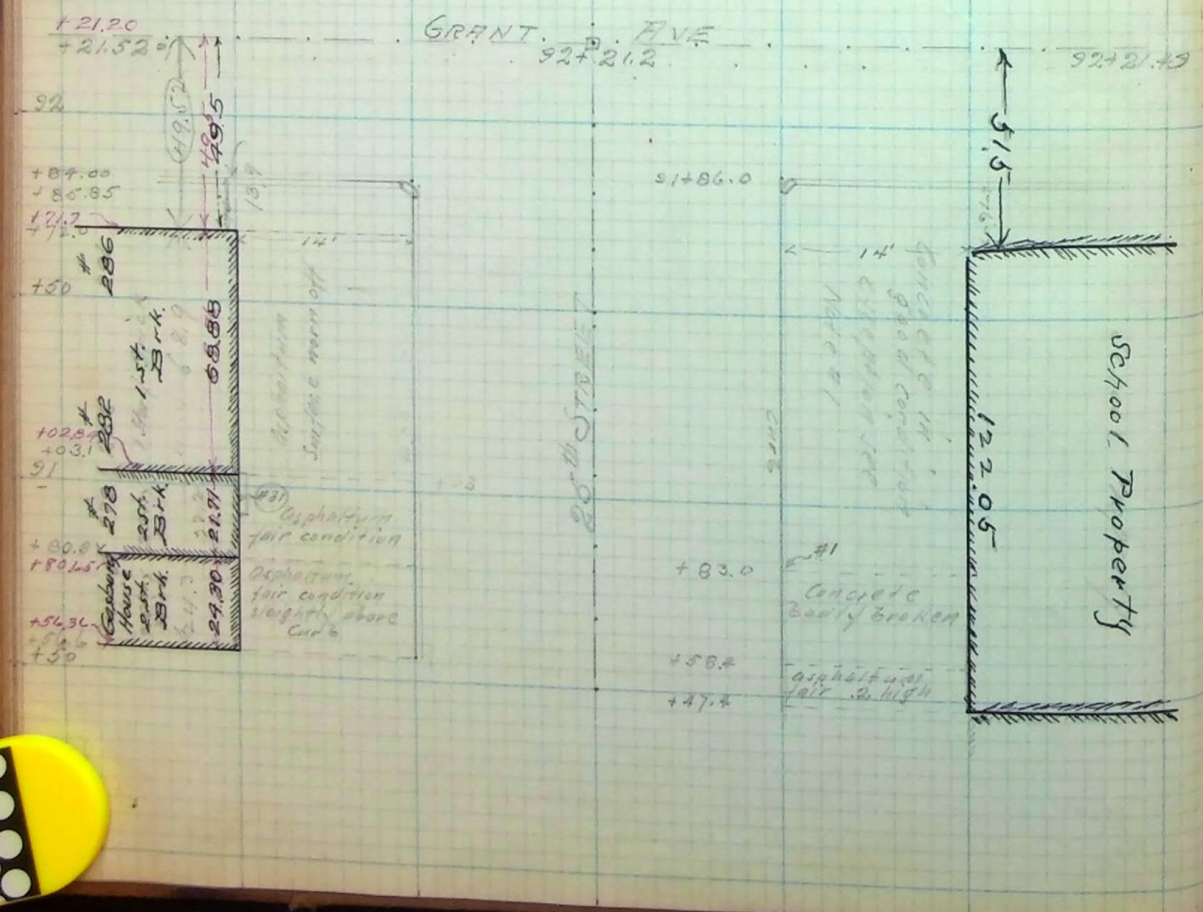

SOUTH SIDE 25TH ST.

#1 = 90+53. Of this point the side walk meets curb grade gradually increasing distance below curb to station 91+86 which is about 1.6 below curb

NORTH SIDE 25TH ST.

#31 = 90+90.2 W. end of basement ventilator 4.0 Wide 12.8 Long