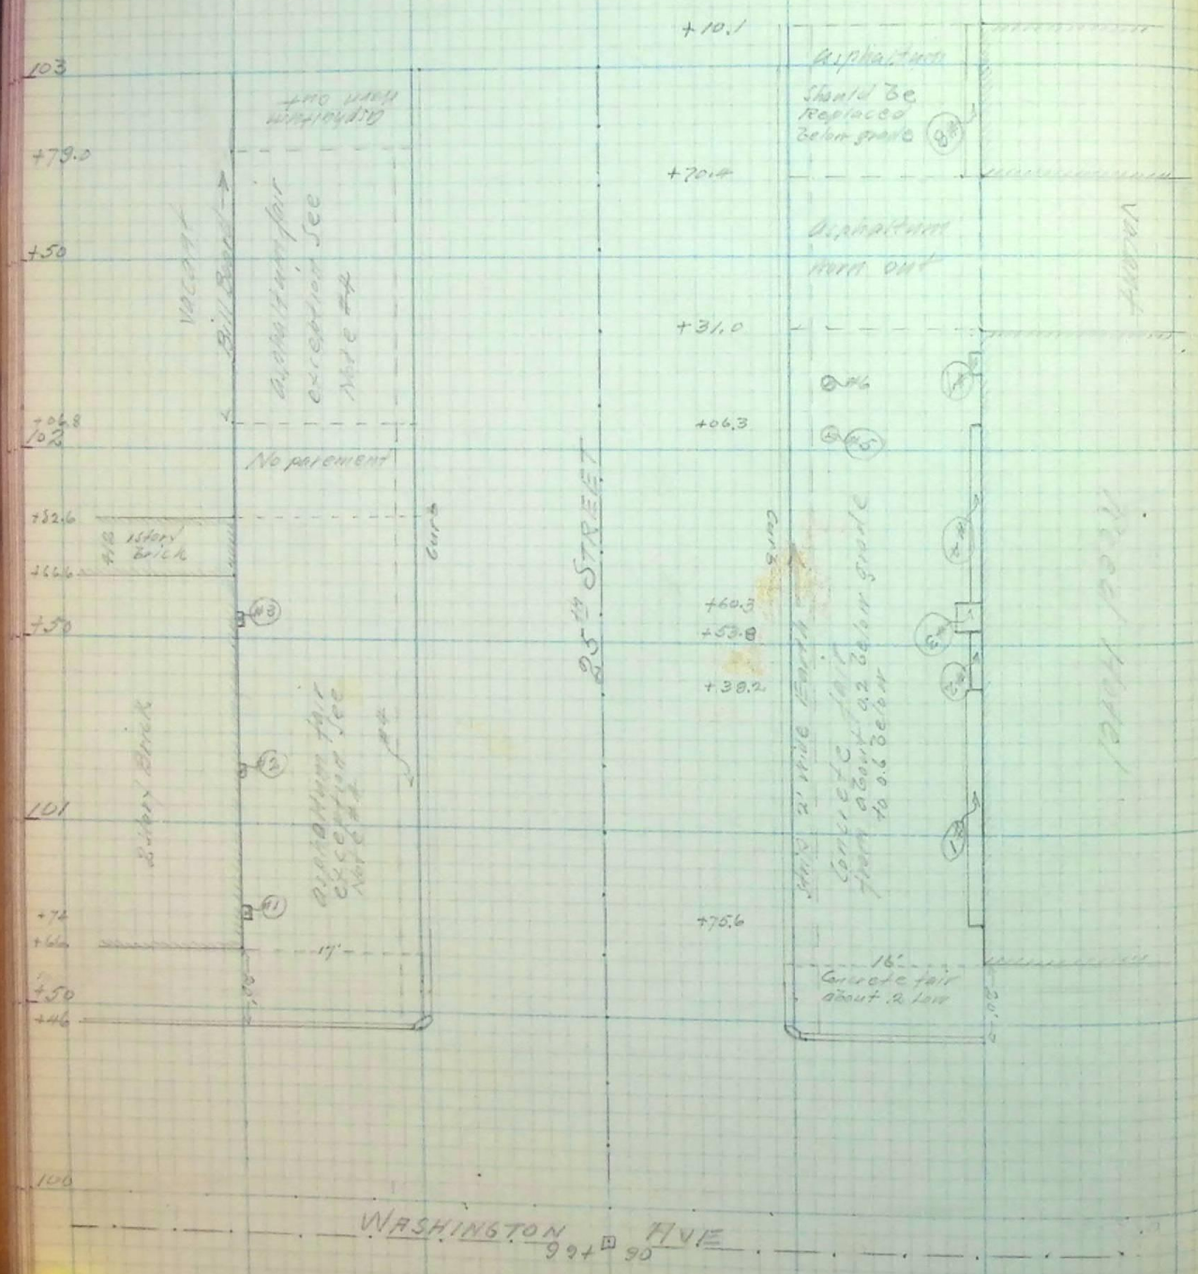

SOUTH SIDE 25½ St.

#1 = 100+75.6 W. end of Basement Entrance 5.0 Wide 37.4 Long
#2 = 101+38.2 W. " " " Ventilation 3.5 " 15.6 "
#3 = 101+53.8 " " " Storm Doors Entrance Reed Hotel #0 Wide 6.5 Long
#4 = 101+60.3 " " " Basement Ventilation 3.5 Wide 46.0 Long
#5 = 102+04.0 C of Manhole Coal Shute 2' dia 3.6 from curb
#6 = 102+19.0 " " " " " " " " 3.6 " "
#7 = 102+19.0 W. end of Basement Ventilation 3.5 Wide 7.5 Long
#8 = 102+70.4 " " " " Entrance 5.5 " 39.7 "

NORTH SIDE 25th St.

#1 = 100+74 W. Side of Basement Ventilator 3.0 Wide 4.5 Long
#2 = 101+13.6 " " " " " 3.0 " 4.5 "
#3 = 101+53.1 " " " " " 3.0 " 4.5 "
#4 = 100+46.0 Strip of walk Broken uneaven alignment about 2' wide short old walk about .5 above curb and continues to Sta 102+79