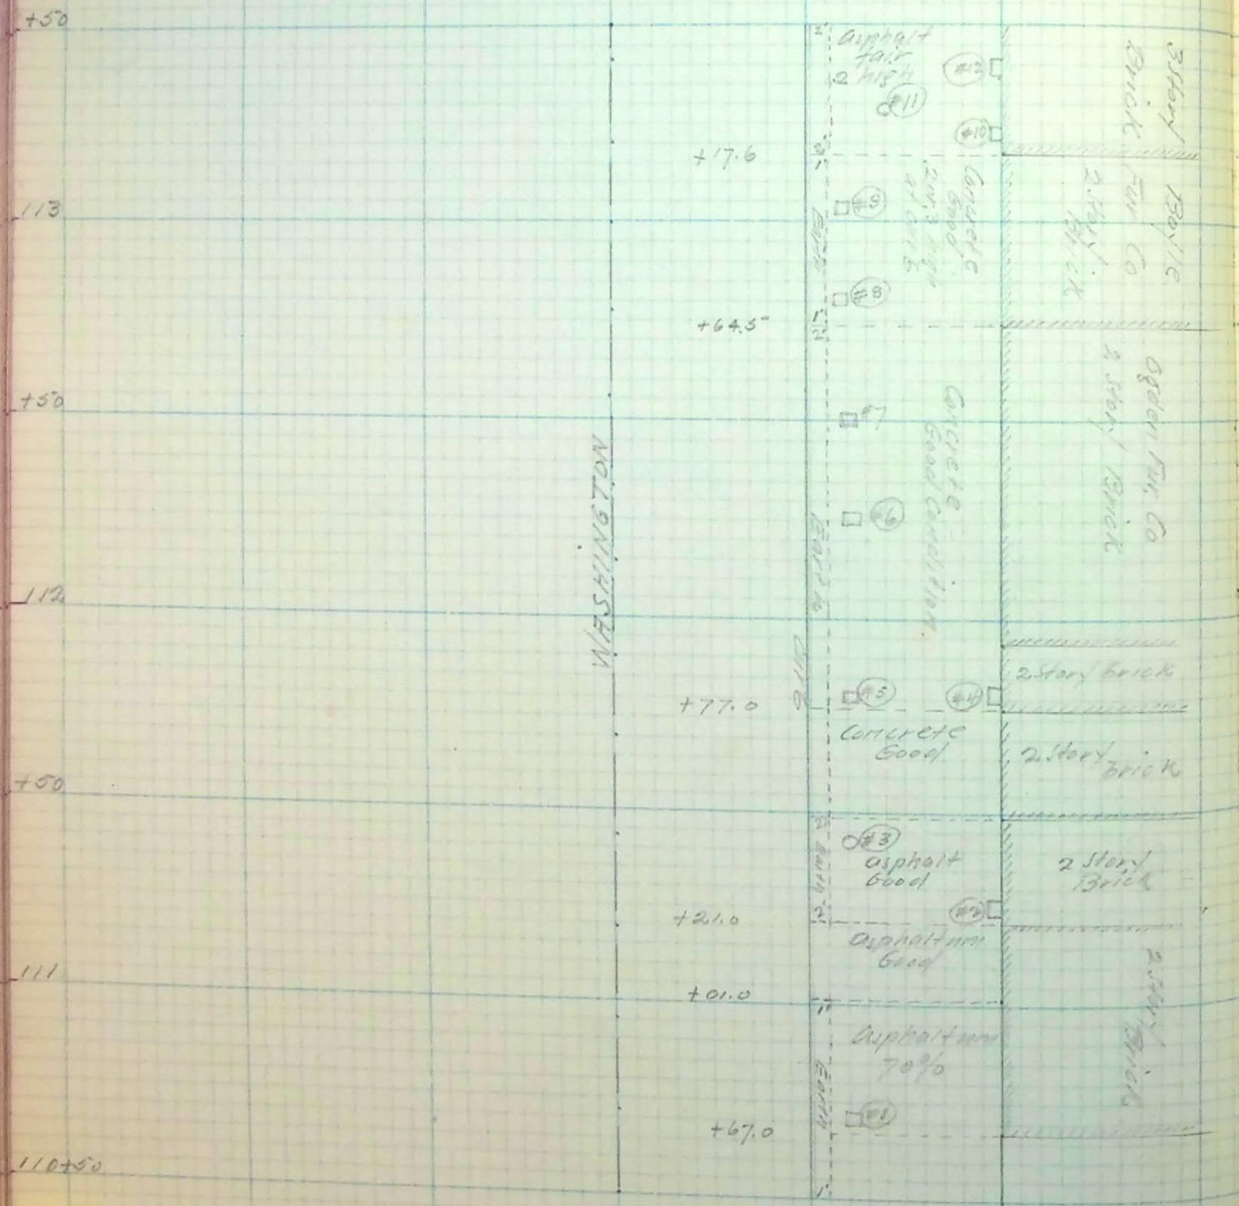

E. Side of Washington Ave.

#1 = 110+68.5	S. Side of Basement iron trapdoors	3.8	wide	4.4	Long	4.7 from curb
#2 = 111+23.2	" " " " ventilator	6.0	"	6.9	"	
#3 = 111+43.0	Ctr " " " M.H.	2.9 dia		4.0	from curb	
#4 = 111+78.2	S. Side " " Entrance	4.0	Wide	10.0	Long	
#5 = 111+78.2	" " " " iron trapdoors	3.0	"	3.7	"	5.0 from curb
#6 = 113+34.8	" " " " " " "	3.7	"	6.7	"	3.4 " "
#7 = 113+48.5	" " " " " " "	3.7	"	6.7	"	3.4 " "
#8 = 112+79.3	" " " " " " "	3.6	"	7.0	"	2.5 " "
#9 = 113+01.0	" " " " " " "	3.6	"	7.0	"	2.5 " "
#10 = 113+20.3	" " " " ventilator	4.0	"	5.2	"	
#11 = 113+28.2	Ctr. of " " M.H.	2.0	dia	10.0	from curb	
#12 = 113+37.0	S. Side " " ventilator	4.0	Wide	5.2	"	