


121
+50
120
+50
119
+50
118

WASHINGTON

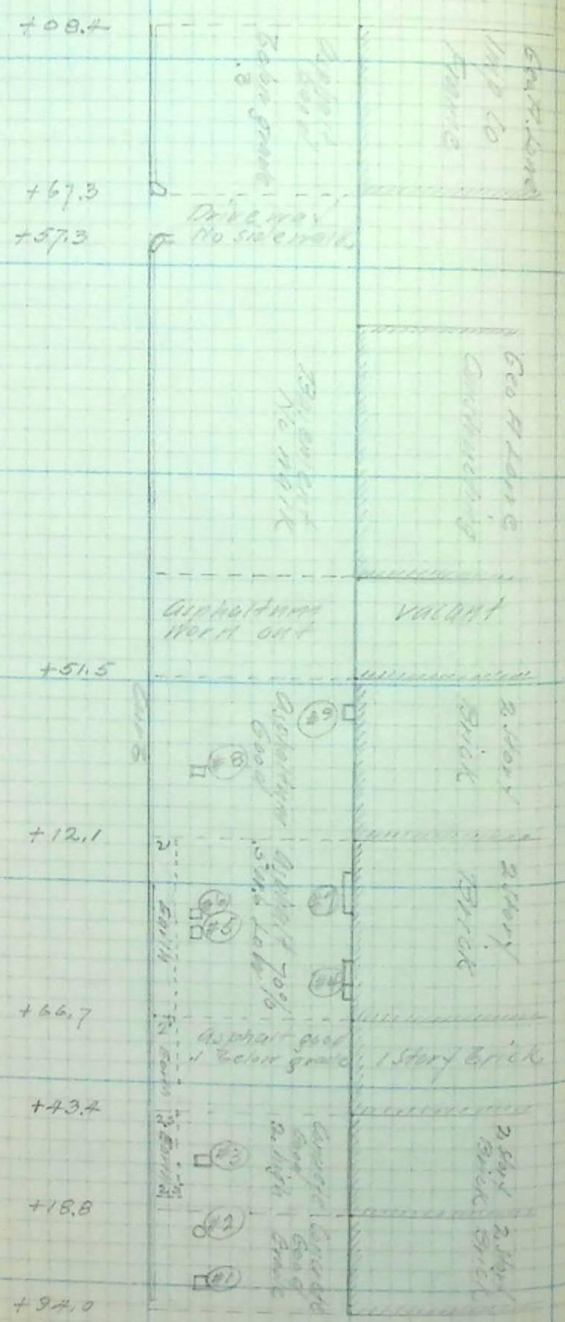

EAST SIDE WASHINGTON FIVE

- #1=117+892 S. Side of basement iron trap door 4.0 wide 4.7 Long 2.9 from curb
- #2=118+44.1 Ch " " " M.H. 2.4 dia 2.8 " "
- #3=118+289 S " " " iron trap doors 4.5 " 5.5 " 3.8 " "
- #4=118+717 " " " " Ventilator 3.0 " 13.1 "
- #5=118+852 " " " " iron trap doors 4.2 " 5.6 " 5.7 " "
- #6=119+908 " " " " " " " 4.5 " 5.6 " 5.7 " "
- #7=118+933 " " " " Ventilator 3.0 " 16.2 "
- #8=119+227 " " " " iron trap doors 3.8 " 4.0 " 3.8 " "
- #9=119+418 " " " " Entrance 5.0 " 5.3 "