

A.F.P.
H.H.H.
Sbarr

LINCOLN


Ave

085

Sidewalk inspection
by Sam. May 17.04

086

86+45.3

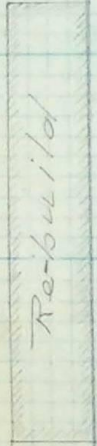


087

25th Street

088

85+60.9

089

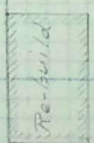


89+37.3


090

90+05.3

90+48.3

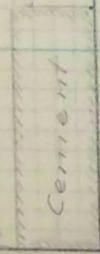

091

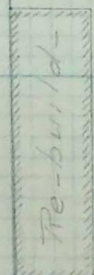

90+39.0

Prop line
91+717

Grant

Ave

Hall

77+39.7

Ave

31

Sidewalk
inspection by
Committee cont'd

078


78+97



079

79+68


80+09.3

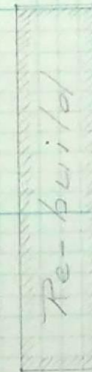

080

25th St.

90+23.5

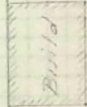


081

81+55.8


082

82+64.9

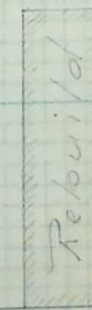

083

82+23.2

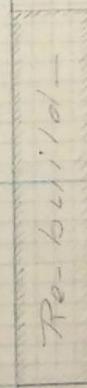

084

LINCOLN

Ave