


Location of Ctr of 2<sup>nd</sup> Street  
 East and West from Washington Ave  
 and North Prop Lines 33' from Center

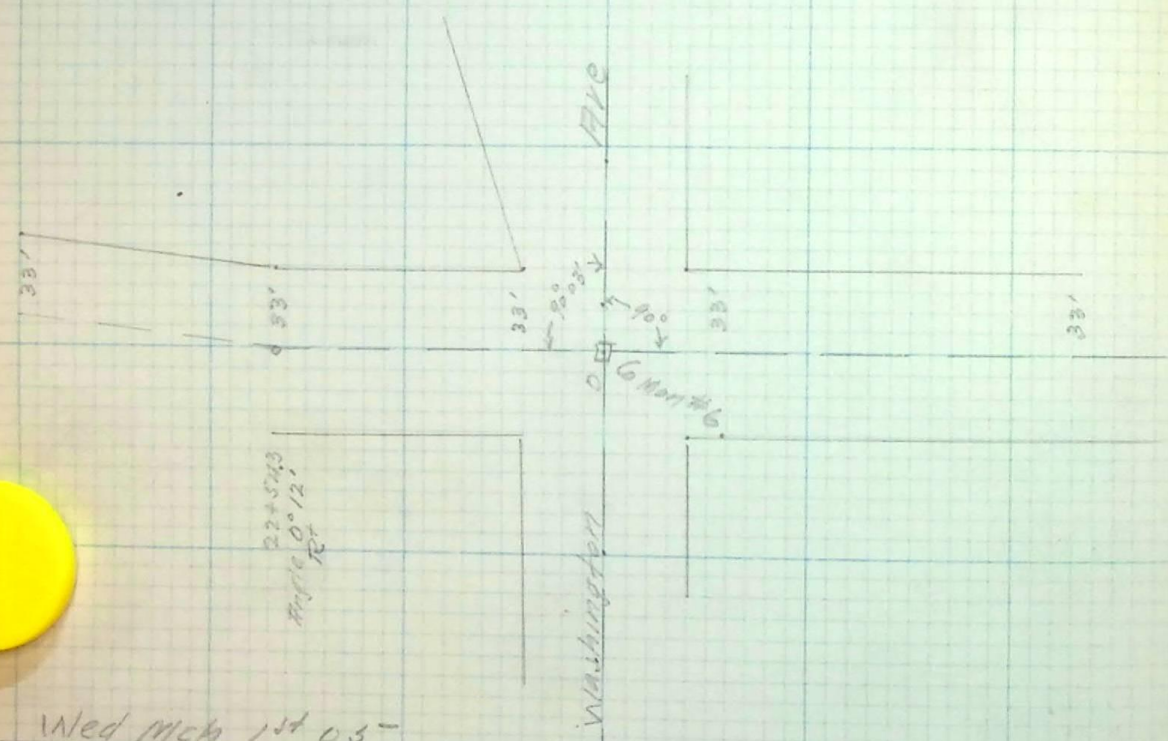

Wed Mch 1st 05-  
 Lantz  
 Parker  
 Stone