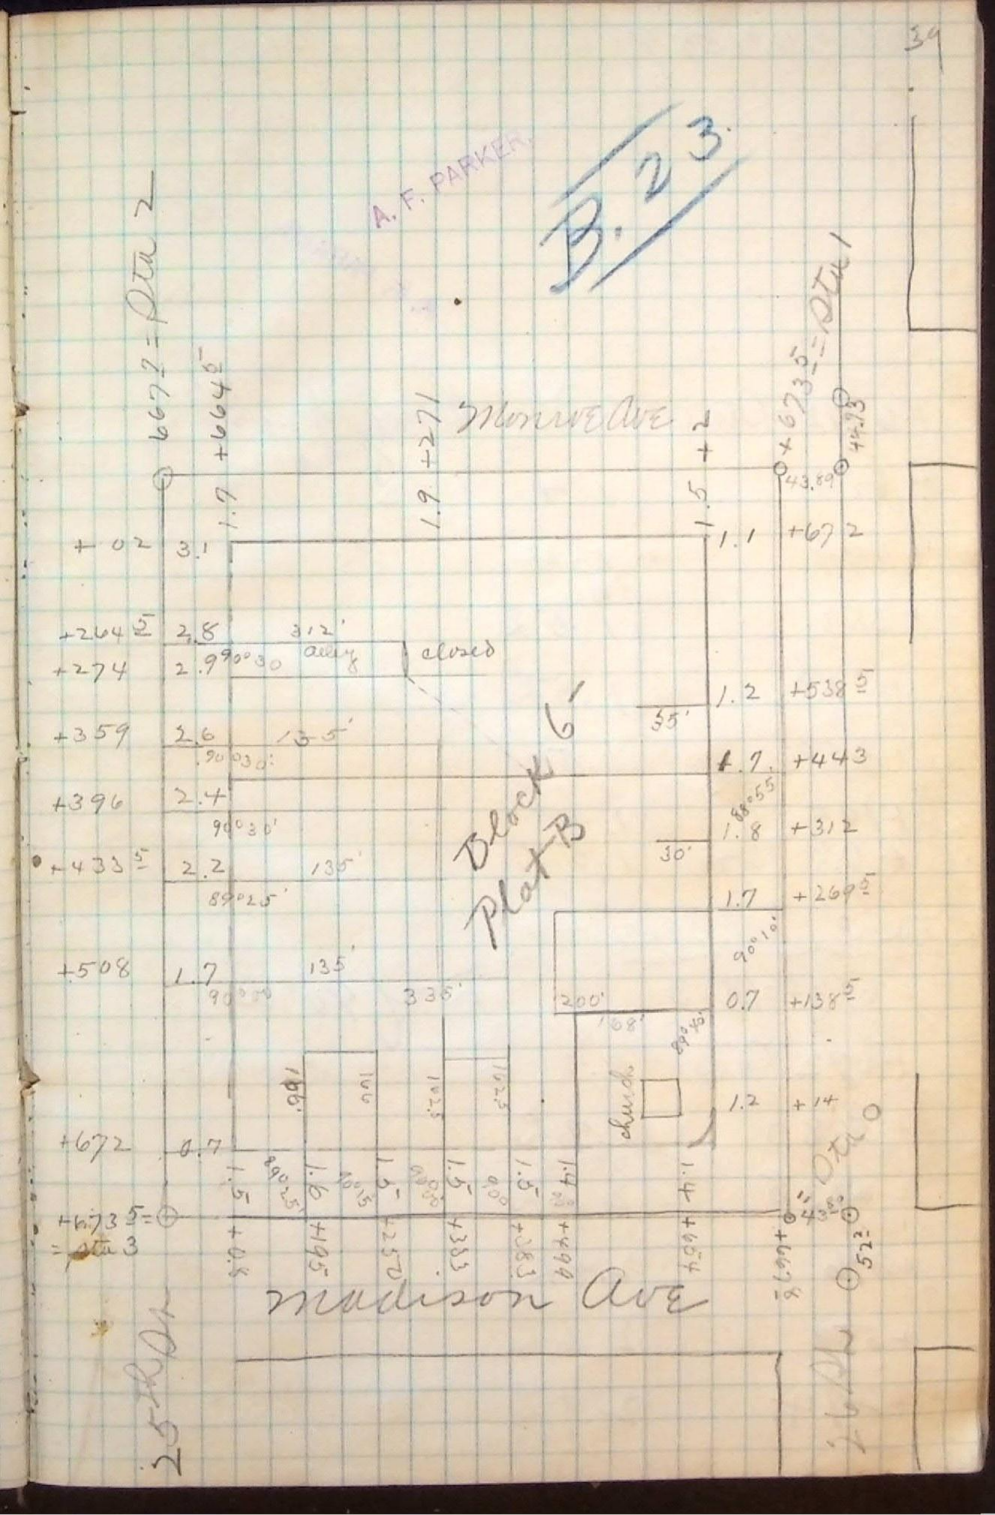
B. 23.
A. F. PARKER
Block 6
Plat B
Monroe Ave
Madison Ave
Monroe Ave
church
closed
alley
+6672 = Sta 2
+6735 = Sta 1
+6735 = Sta 3
+664.5
0
1.1
1.2
1.7
1.8
1.7
0.7
1.2
1.4
1.5
1.6
1.5
1.5
1.5
1.7
2.2
2.4
2.6
2.9
2.8
3.1
0.7
1.7
1.9
1.5