


May 18"

A. F. PARKER.

North Ogden ditch

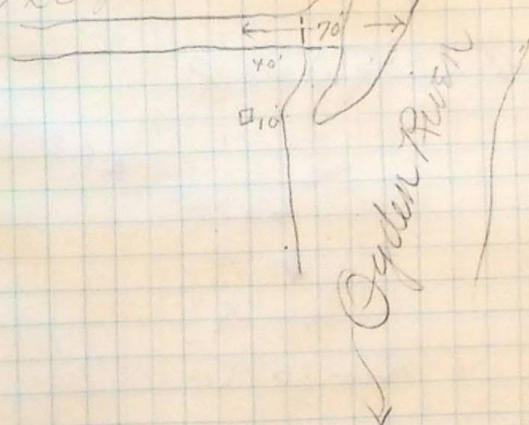

wing dam

70'
40'
100'

Ogden River