

26 Curb elevations W. Side  
Grant Ave 24<sup>th</sup> St. to 23<sup>rd</sup> St.


18' Walk	+ Hi. 1	-	Grade
24 <sup>th</sup> - Grant			
B.M. 11953	4.12	4306.945	4302.825
115+76.74			4.5072
116			4.6107
+50			4.8331
117			5.0555
+50			5.2779
118			5.5003
+50			5.7227
119	Change of grade	X	5.945
T.P.	4.255	4305.253	5.945
+50			4.3252
120			4.3955
+50			4.4657
121			4.5360
+50			4.6062
122			4.6765
+41.76			4.7352
+55.76			
B.M. 11953	23 <sup>rd</sup> - Grant	4.120	4301.135

Curb = 31.5' W. of Mar. 1198

Tues, June 13-04  
Lantz  
Jenkins  
Shatt

JUN 13 1904

23<sup>rd</sup> Street

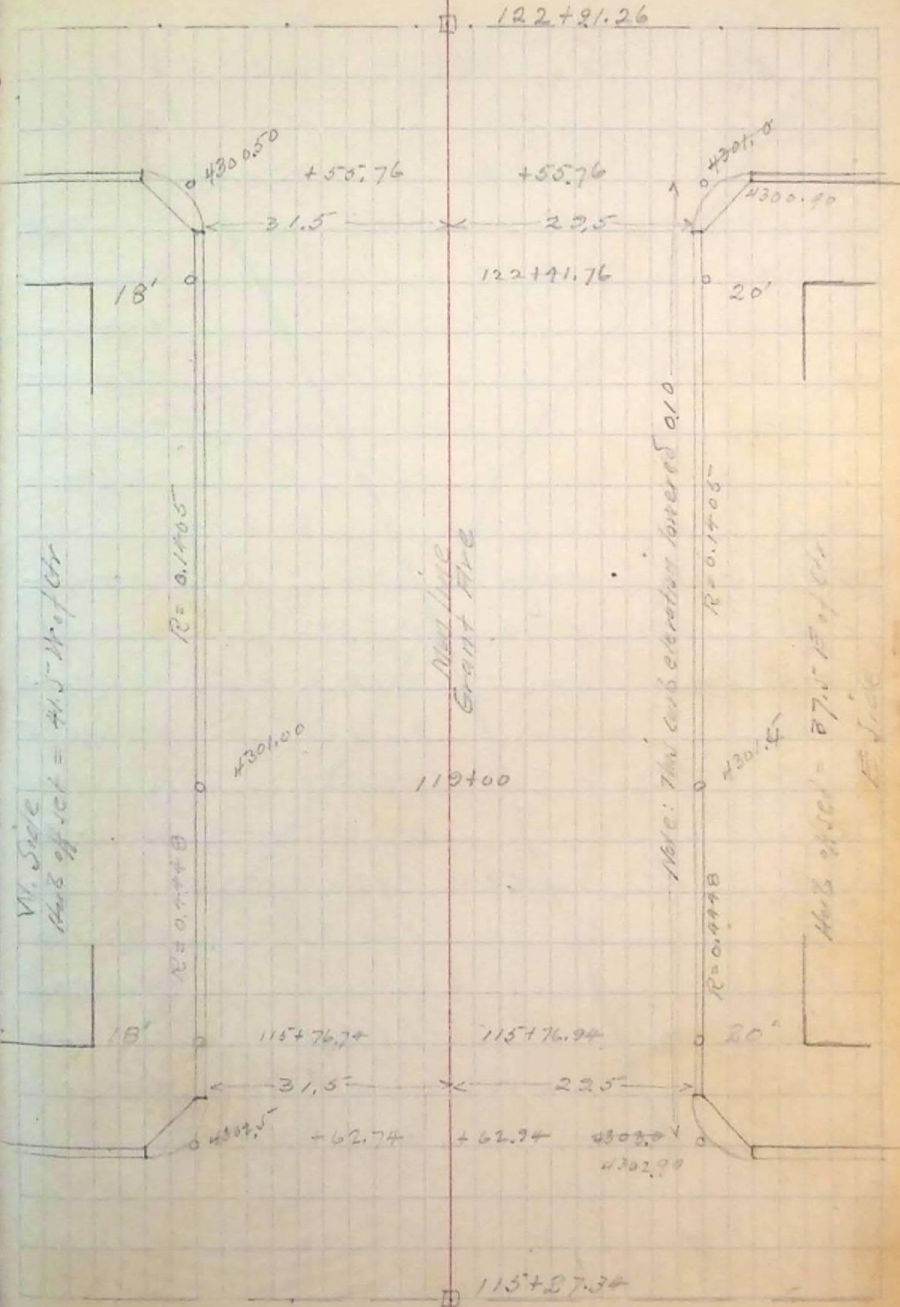

24<sup>th</sup> Street