

Curb elevations N. Side


19.0' 24<sup>th</sup> Street, bet. Lincoln and Grant

~~18.5'~~ Walk Edge hubs set 6.5' S. of hub line

24 <sup>th</sup> Grant	+	H. I	-	Grade	
B.M. Rail Box	3.635	4306.4600		4302.825	
91+85.7		Curb			
+ 717	Grant, W. Prop line	3.9900	✓	4302.47	
+ 50		4.0375	✓	4342.4225	
91		4.1454	✓	4302.3146	
90+50		4.2533	✓	4302.2067	
90		4.3612	✓	4302.0988	
T.P.	3.935	4305.8800	4.575	4301.945	
89+50			3.8891	✓	4301.9909
89			3.9970	✓	4301.8830
88+50			4.1049	✓	4301.7751
88			4.2128	✓	4301.6672
+50			4.3207	✓	4301.5593
87			4.4286	✓	4301.4514
+50			4.5365	✓	4301.3435
86			4.6444	✓	01.2356
T.P.	4.240	4305.4750	4.646	4301.235	
85+50			4.3473	✓	01.1277
85+04.7	Lincoln E Prop line	4.4450	✓	01.03	
84+90		Curb "			
Mon., 24 <sup>th</sup> Lincoln			4.575	4300.880	

Note: Curb line changed to 19' walk  
June 23<sup>rd</sup> 04

JUN 20 1904

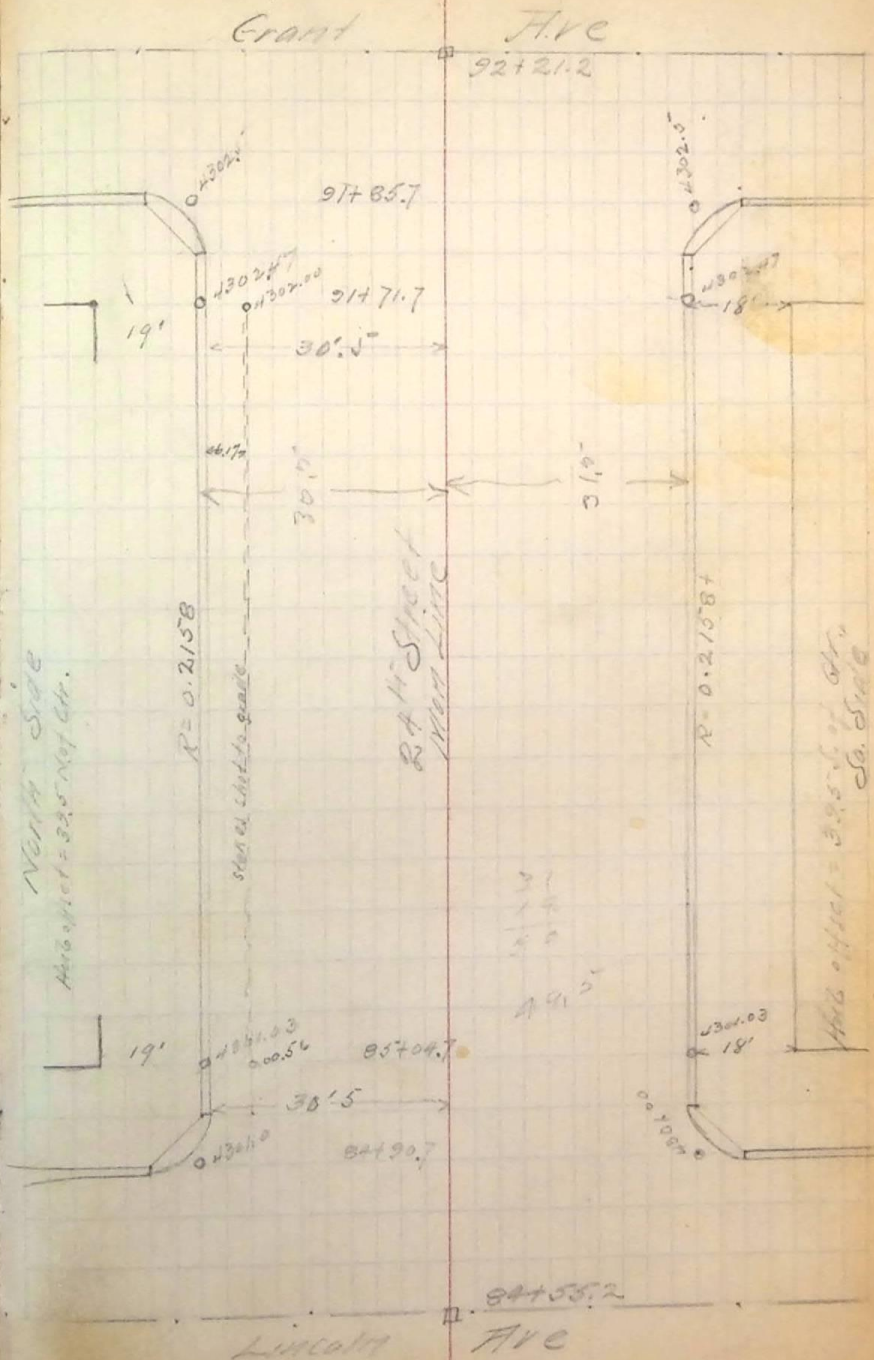

Lincoln Ave

84+58.2