45
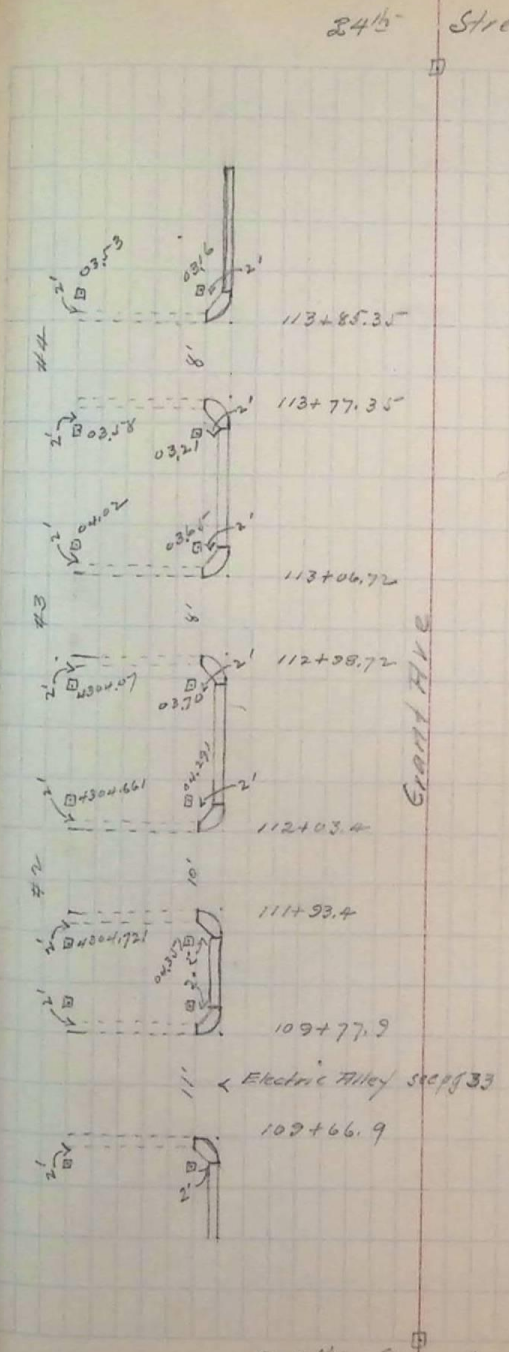
Location and Grades for
Driveways W. Side Grant Ave
Bet. 25½ and 24½ Streets