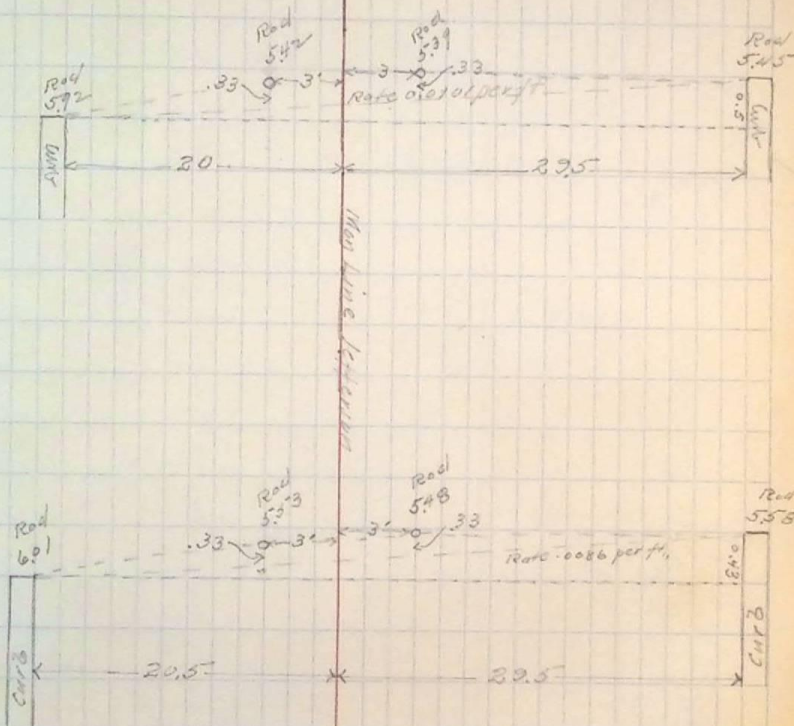


Grades for Top of Cutler

S. Side 25th St. across Jefferson Ave

Grades for top of Cutler

N. Side 25th St. across Jefferson Ave

Wed. Aug 31st 04
 L. E. J.
 L. A. J.
 S. W. J.