Grades for Street RY
Jefferson Ave to Monroe Ave

Sta	+	H.I	−	Ele	Grade
	5.052	4385.24		4380.188	
114+90.83	W. prop Jefferson Ave		5.45		4379.79
115+40.33	Ctr. " "				
115+89.83	E. " " "		4.54		4380.70
116			4.39		4380.85
+50			3.75		4381.59
117			2.905		4382.335
+50			2.165		4383.075
T.P.	6.86	4389.95	2.15	4383.09	
118			6.13		4383.82
+50			5.39		4384.56
119			4.645		4385.305
+50			3.905		4386.045
120			3.16		4386.79
+50			2.43		4387.52
121			1.685		4388.265
T.P.	5.25	4393.50	1.70	4388.25	
+50			4.495		4389.005
122			3.75		4389.75
+51.53	W prop Madison		2.98		4390.52
123+01.03	Ctr. "		2.68		4390.82
B.M. Mag 25 - Madison			3.12	4390.38	
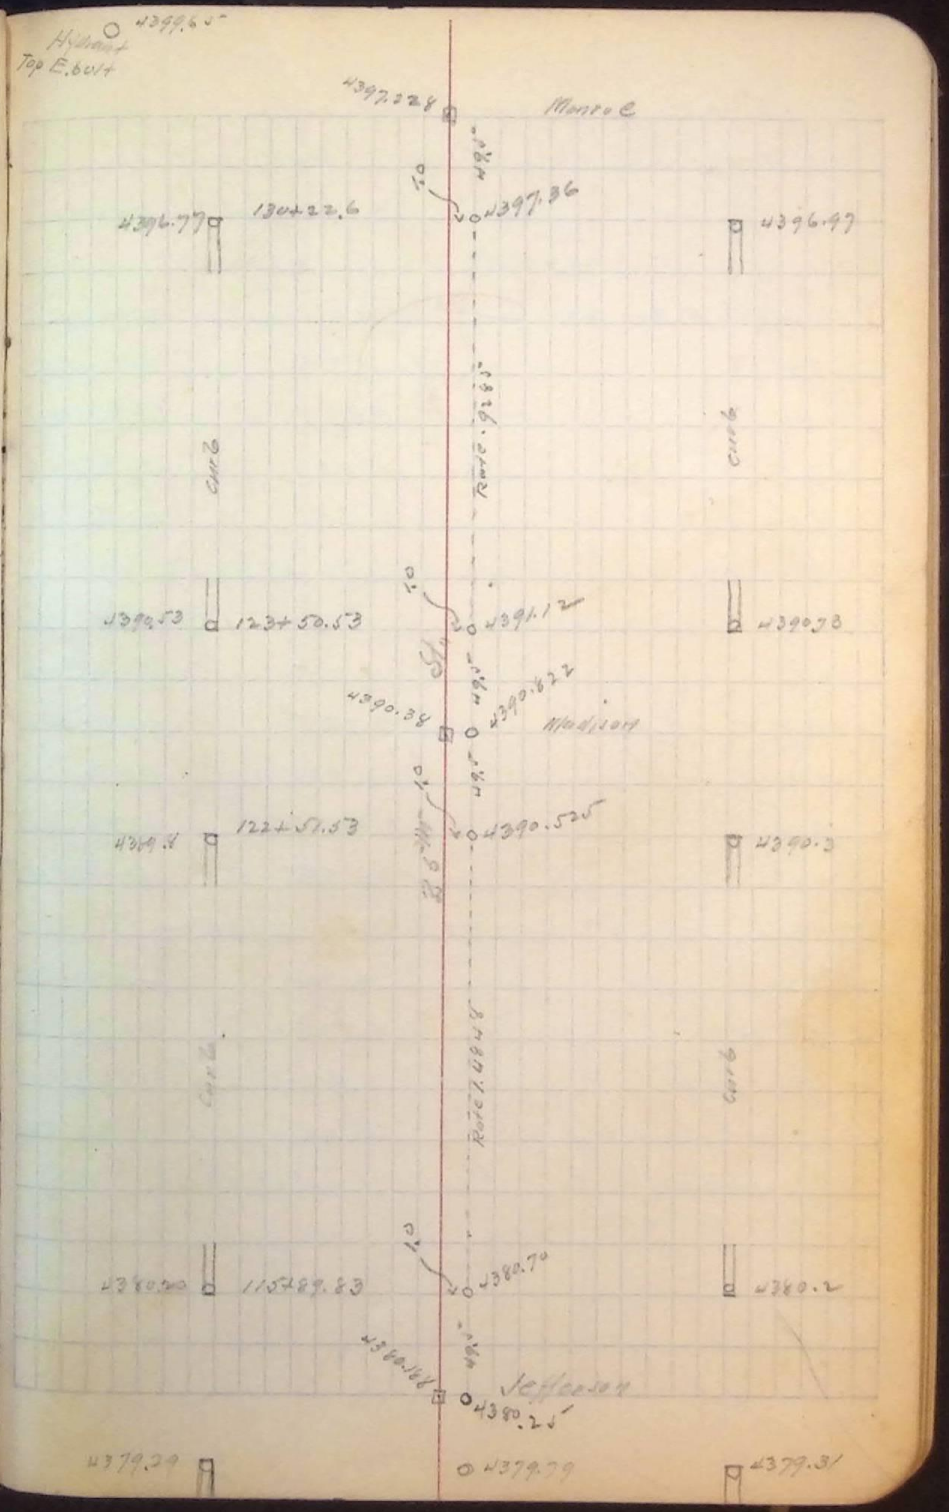
Continued next pg