

57 Grades for top of Gutter
across Madison Ave. N. Side 24th St.

E Side on curb

Rod
3.80
+ .19
3.99
- .33
3.66

Rod .33 above grade line
24.8 from curb

W Side on curb

4.20
- .16
4.04
- .33
3.71

Rod .33 above grade line
20.8 from curb

Grades for top of Gutter


across Madison Ave S. Side 24th St.

E. Side on curb

3.34
+ .38
3.72
- .33
3.39

W. Side on curb

4.14
- .32
3.82
- .33
3.49

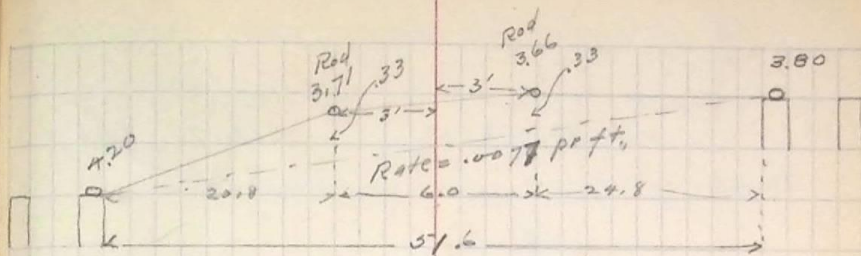

Mon. Aug 29-04
Len 12
Shaw

